


T. 3N. R. 28E. W.M.

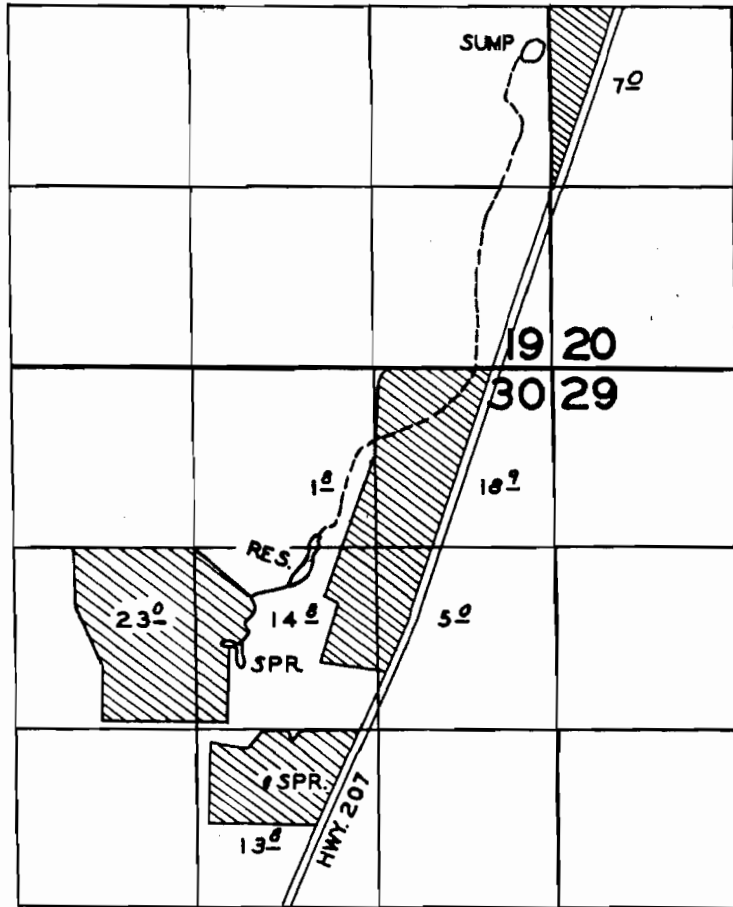

FINAL PROOF SURVEY
UNDER

Application No. 31906..... Permit No. 25159.....
IN NAME OF

GAYLORD M. MADISON

Surveyed JULY 21, 1960., by *[Signature]*