


# T. 3 N. R. 28 E. W. M.

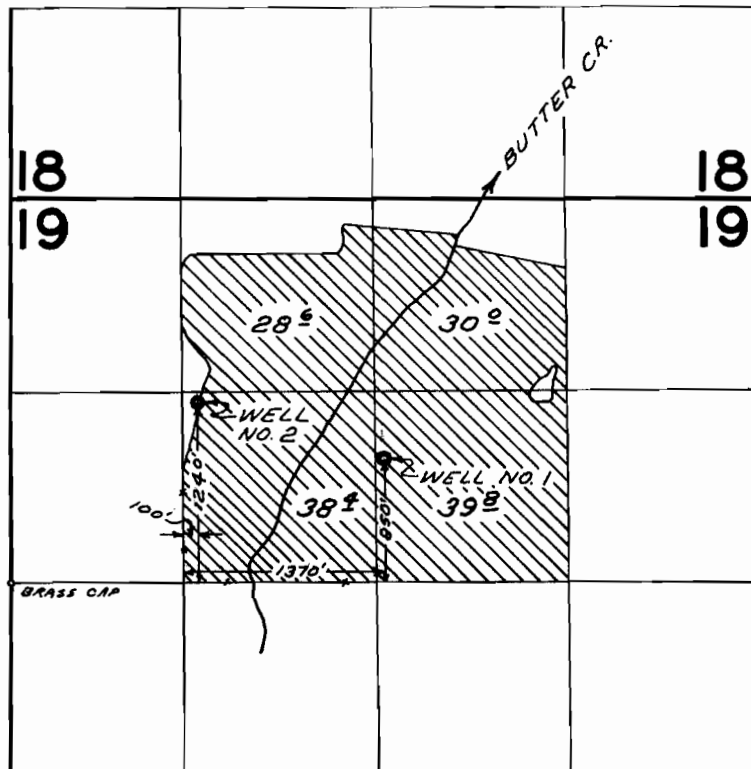

## FINAL PROOF SURVEY UNDER

Application No. G-515 Permit No. G-438  
IN NAME OF

FRED AND TRESA DAVIS

Surveyed JUL 21 1960, by R. JACKSON  
JUN 22 1967 L. E. GOULD