


T.3N.R.28E.W.M.

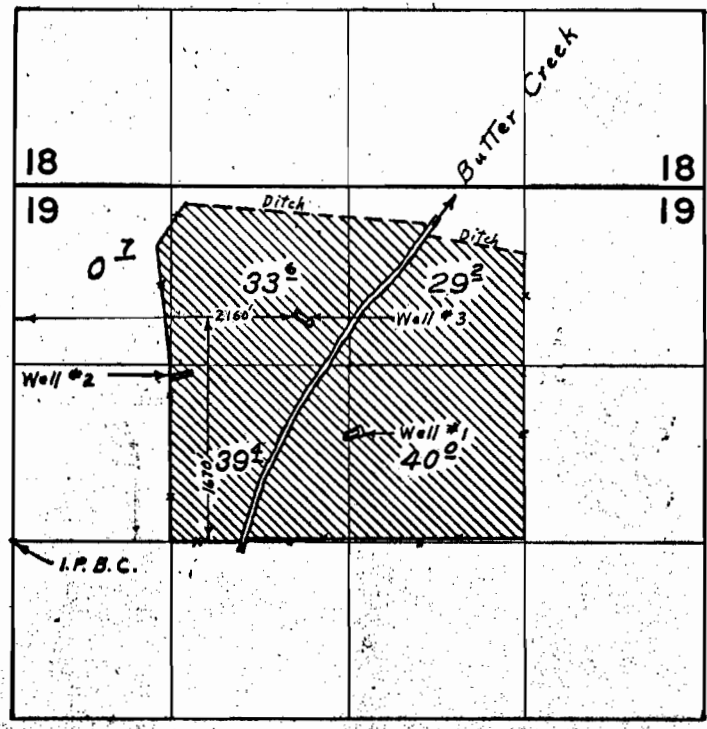

FINAL PROOF SURVEY UNDER

Application No. G-2786 Permit No. G-2597
IN NAME OF
FRED E. DAVIS

Surveyed June 22, 1967, by L. E. Gould