


CLAIM OF BENEFICIAL USE MAP

UNDER APPLICATION R-85278; PERMIT R-13515

NW1/4 SE1/4 SEC 7 T 22S R 39E W.M.

U.S.G.S. QUAD - MONUMENT PEAK, OREG. - 7 1/2'

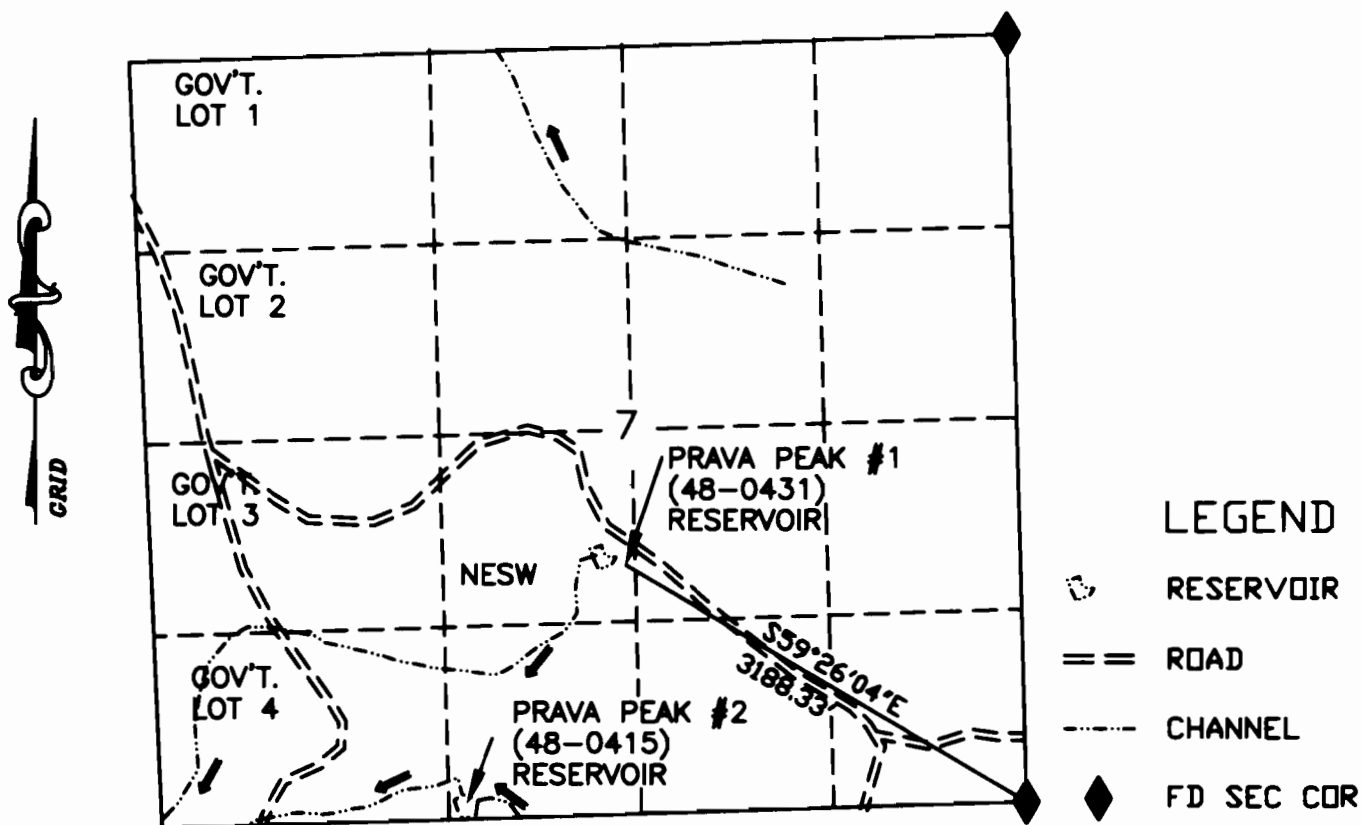


RECEIVED

PRAVA PEAK #1 (48-0431) RESERVOIR

OCT 01 2007

ASSESSORS MAP 22S39E
TAX LOT 200

WATER RESOURCES DEPT.
SALEM, OREGON

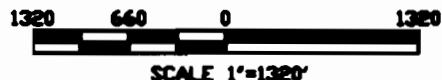

I, Charles E. Jay, Administrative Officer, Vale BLM agree to the findings of the CWRE and do submit this site report and map as my Claim of Beneficial Use of the water as provided under the terms and conditions of my Permit R-13515

Charles E. Jay



THIS MAP IS FOR THE PURPOSE OF LOCATING A WATER RIGHT AND IS NOT INTENDED TO PROVIDE LEGAL DIMENSIONS FOR LOCATION OF PROPERTY BOUNDARIES.

ACASBBS
BWS FILEPRAVAI-BENE

UNITED STATES DEPARTMENT OF THE INTERIOR BUREAU OF LAND MANAGEMENT DIVISION OF OPERATIONS VALE DISTRICT	
PRAVA PEAK #1 (48-0431) RESERVOIR	
DESIGNED: <i>Thomas R. F. [Signature]</i>	
REVIEWED: <i>Donald R. [Signature]</i>	
APPROVED: <i>Charles E. Jay</i>	
DRAWN: CG	SCALE: 1"=1320'
DATE: 11/22/06	SHEET 1 OF 1
DRAWING NO. DR-03-9172.45-1279	