


# CLAIM OF BENEFICIAL USE MAP

UNDER APPLICATION R-85149 ; PERMIT R-13481

SE1/4SE1/4 SEC 35 T 27S R 44E W.M.

U.S.G.S. QUAD - MCCAIN CREEK, OREG. - 7 1/2'

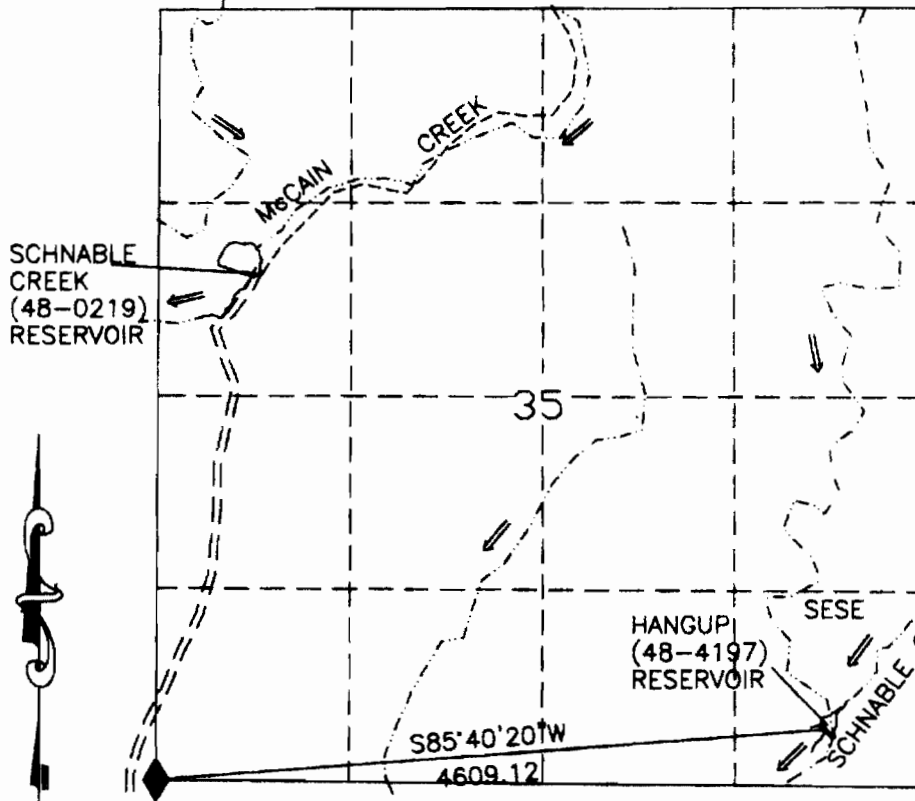


- LEGEND**
- RESERVOIR
  - ROAD
  - CHANNEL
  - FD SEC COR
  - RESERVOIR (NOT ON QUAD)

**RECEIVED**  
 OCT 01 2007  
 WATER RESOURCES DEPT.  
 SALEM, OREGON

## HANGUP (48-4197) RESERVOIR

MAP: 27S44E  
 TAX LOT 200

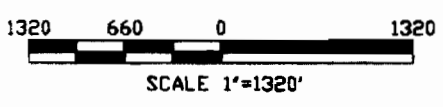

I, Charles E. Joy, Administrative Officer, Vale BLM agree to the findings of the CWRE and do submit this site report and map as my Claim of Beneficial Use of the water as provided under the terms and conditions of my Permit R-13481

*Charles E. Joy*



THIS MAP IS FOR THE PURPOSE OF LOCATING A WATER RIGHT AND IS NOT INTENDED TO PROVIDE LEGAL DIMENSIONS FOR LOCATION OF PROPERTY BOUNDARIES.

ACAD2006  
 DWG FILE: HANGUP-APP-BENE

UNITED STATES DEPARTMENT OF THE INTERIOR BUREAU OF LAND MANAGEMENT DIVISION OF OPERATIONS VALE DISTRICT	
HANGUP (48-4197) RESERVOIR	
DESIGNED:	<i>[Signature]</i>
REVIEWED:	<i>[Signature]</i>
APPROVED:	<i>[Signature]</i> ADM OPERATIONS AND FIELD SERVICES
DRAWN: CG	SCALE: 1"=1320'
DATE: 8/31/07	SHEET 1 OF 1
DRAWING NO. OR-03-9172.45-1131	