


CLAIM OF BENEFICIAL USE MAP

UNDER APPLICATION R-85262; PERMIT R-13475

NE1/4 NW1/4 SEC 23 T 19 S R 40E W.M.

U.S.G.S. QUAD - LITTLE BLACK CANYON, OREG. - 7 1/2'

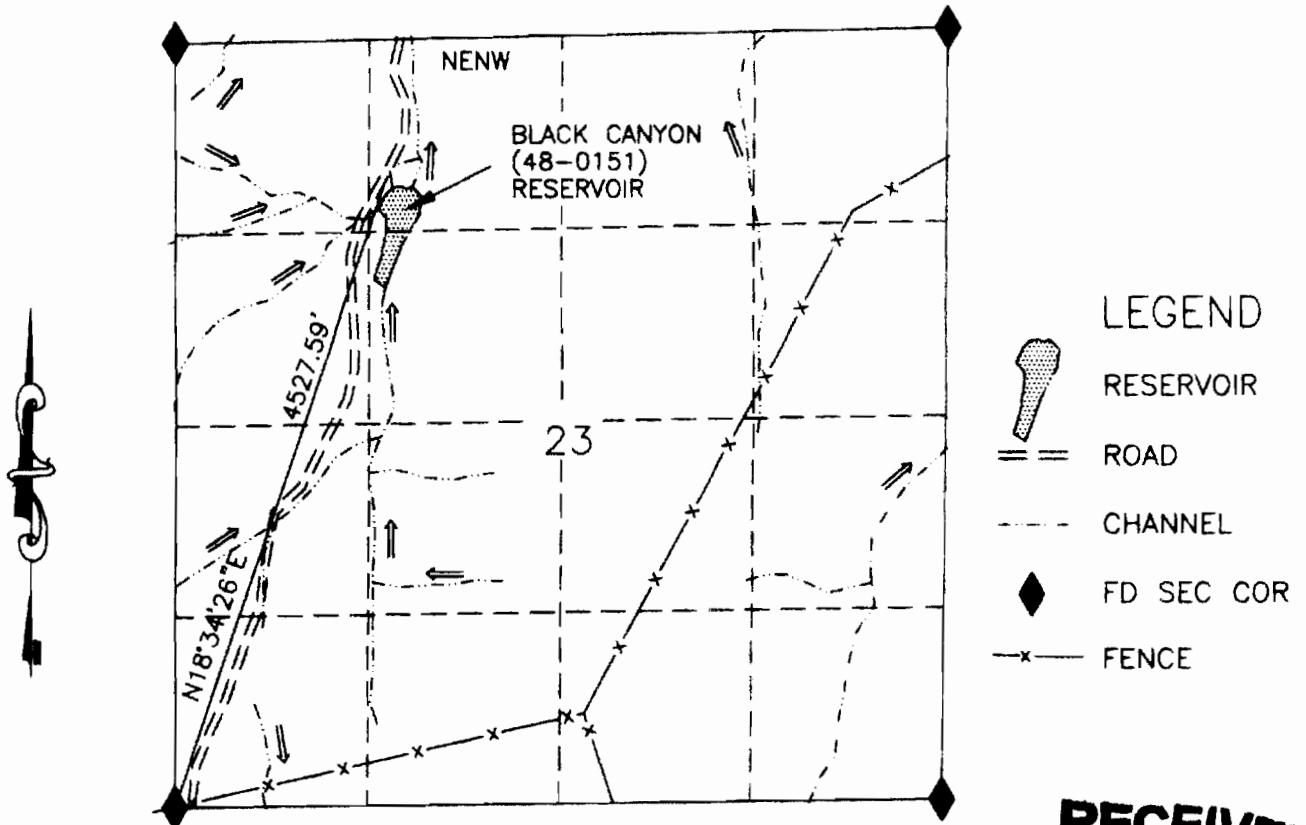


RECEIVED

SEP 10 2007

WATER RESOURCES DEPT
SALEM OREGON

BLACK CANYON (48-0151) RESERVOIR

ASSESSOR MAP 19s40e
TAX LOT NO. 100

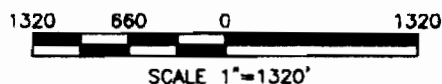

I, Charles E. Joy, Administrative Officer, Vale BLM agree to the findings of the CWRE and do submit this site report and map as my Claim of Beneficial Use of the water as provided under the terms and conditions of my Permit R-13475

Charles E. Joy



THIS MAP IS FOR THE PURPOSE OF LOCATING A WATER RIGHT AND IS NOT INTENDED TO PROVIDE LEGAL DIMENSIONS FOR LOCATION OF PROPERTY BOUNDARIES.

ACAD2006
DWG FILE: BLKCAN-BENE

UNITED STATES DEPARTMENT OF THE INTERIOR BUREAU OF LAND MANAGEMENT DIVISION OF OPERATIONS VALE DISTRICT	
BLACK CANYON (48-0151) RESERVOIR	
DESIGNED: <i>[Signature]</i>	
REVIEWED: <i>[Signature]</i>	
APPROVED: <i>[Signature]</i>	ADM OPERATIONS AND FIELD SERVICES
DRAWN: CG	SCALE: 1"=1320'
DATE: 10/23/06	SHEET 1 OF 1
DRAWING NO. OR-03-9172.45-1267	