


T. 22S., R. 31E., W.M.

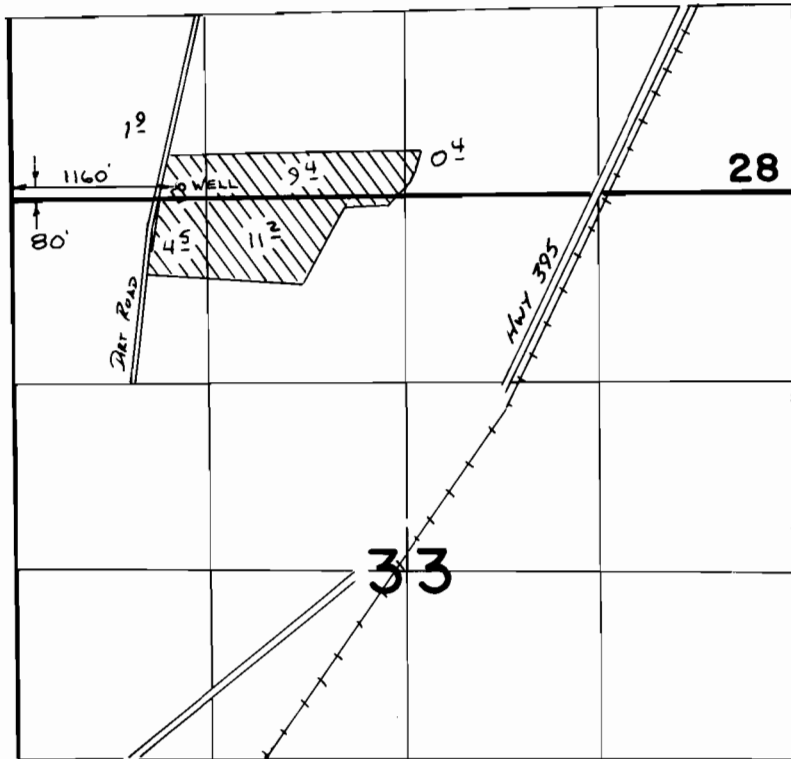

SCALE 1" = 1320'

**FINAL PROOF SURVEY**  
UNDER

Application No. **G:9315**. Permit No. **G:8734**.  
IN NAME OF

.....**ROY**.....**LEE**.....**REED**.....

Surveyed *5:10*..... 1988, by *M. Schmarde*.....