


SEC. 22 T.28S. R.5 W W.M.
DOUGLAS COUNTY

$$1'' = 600'$$

APPLICATION: R-85348
PERMIT #: R-13553

SEE MAP 28 5 15

6	15
---	----

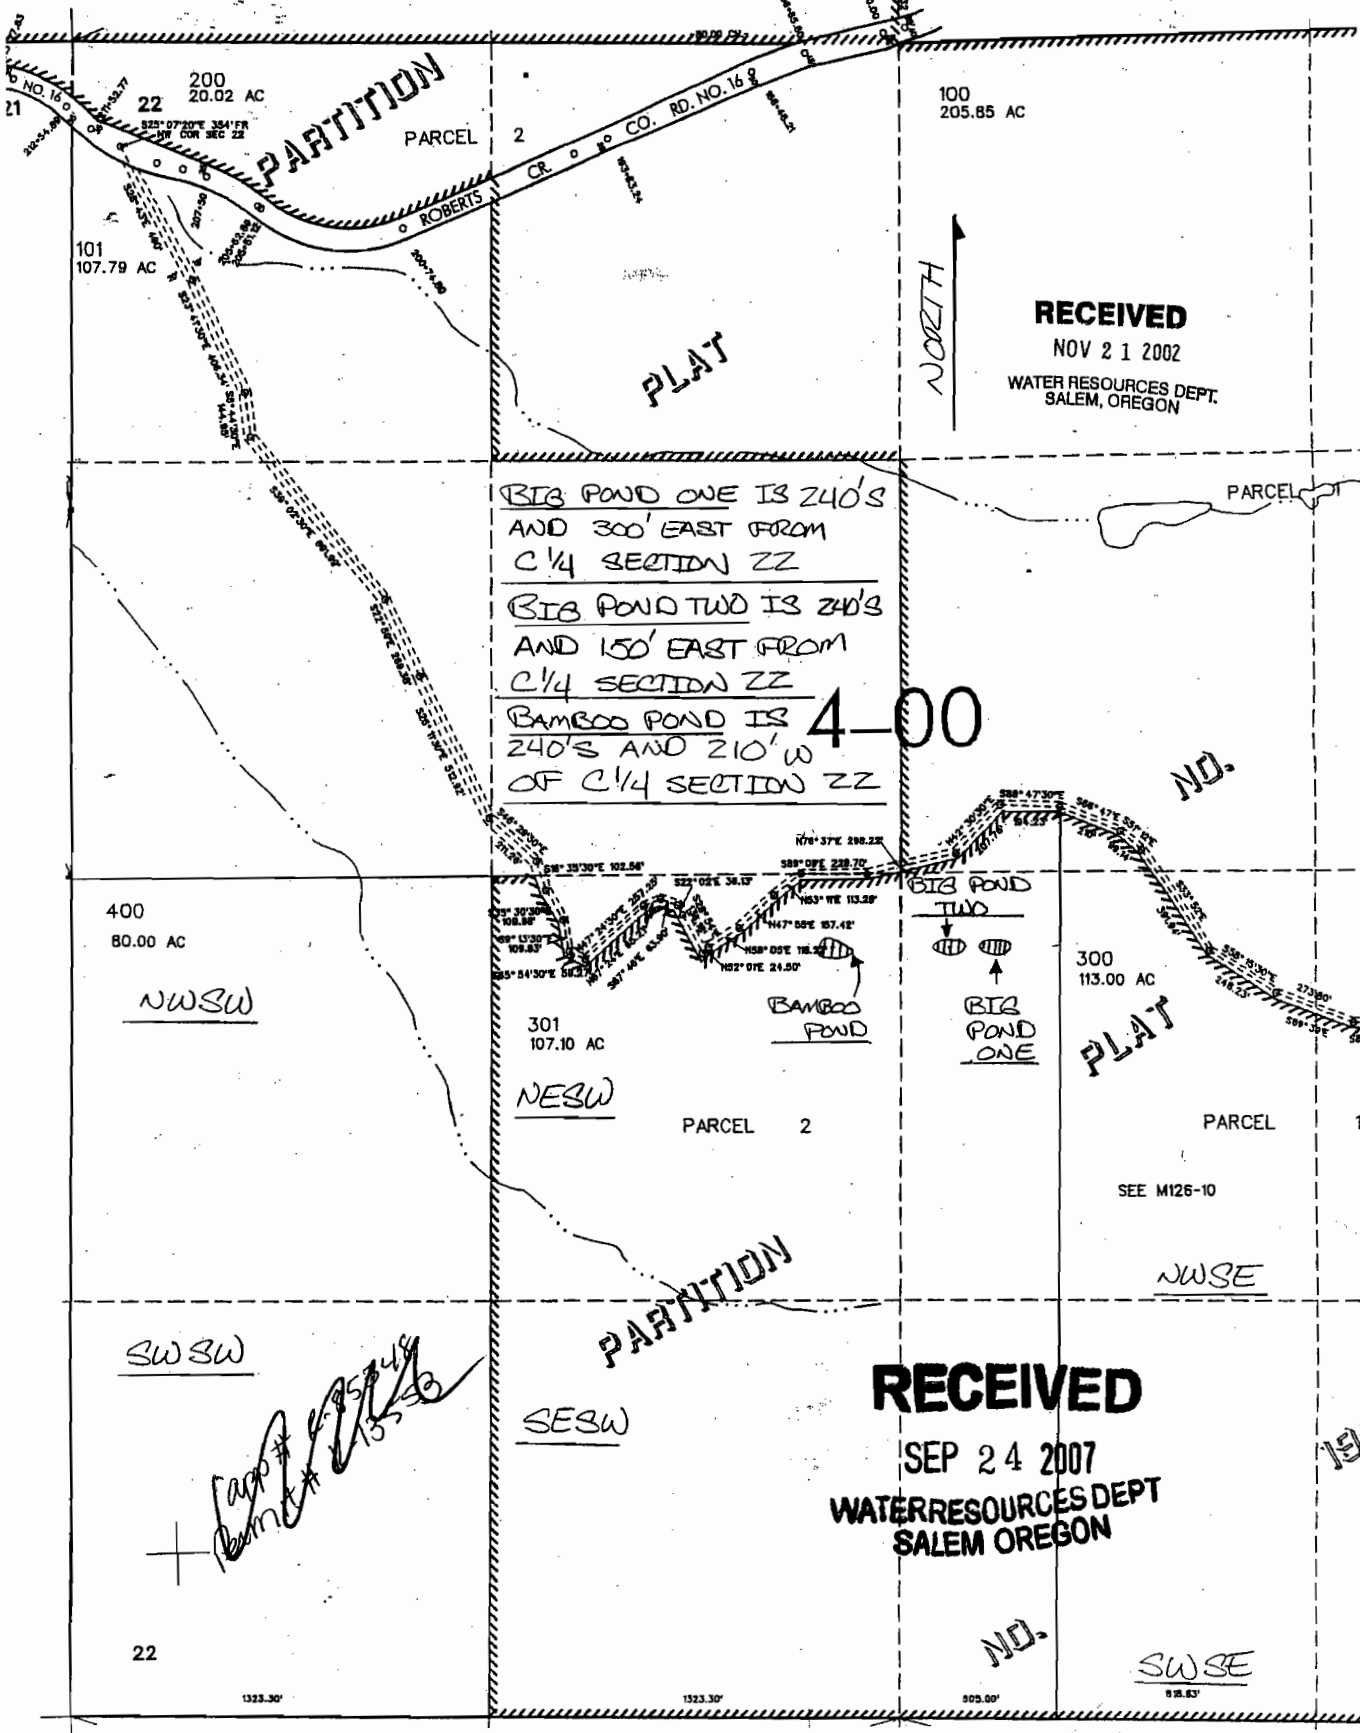

RECEIVED

NOV 21 2002

WATER RESOURCES DEPT.
SALEM, OREGON

BIG POND ONE IS 240'S
AND 300' EAST FROM
C 1/4 SECTION 22

BIG POND TWO IS 240'S
AND 150' EAST FROM
C 1/4 SECTION 22

BAMBOO POND IS 4-
240'S AND 210' W
OF C 1/4 SECTION 22

4-00

400
80.00 AC

NW SW

301
107.10 AC

NESW

PARCEL 2

BIG POND TWO

↓

↑

BIG POND ONE

PLAT

PARCEL

SEE M126-10

NWSE

RECEIVED

SEP 24 2007

WATER RESOURCES DEPT
SALEM OREGON

SW SE