; PREPARED FOR
PURPOSE ONLY

SEC. 22 T.28S. R.5 W W.M.
DOUGLAS COUNTY

~~1"=400'~~

1"=600'
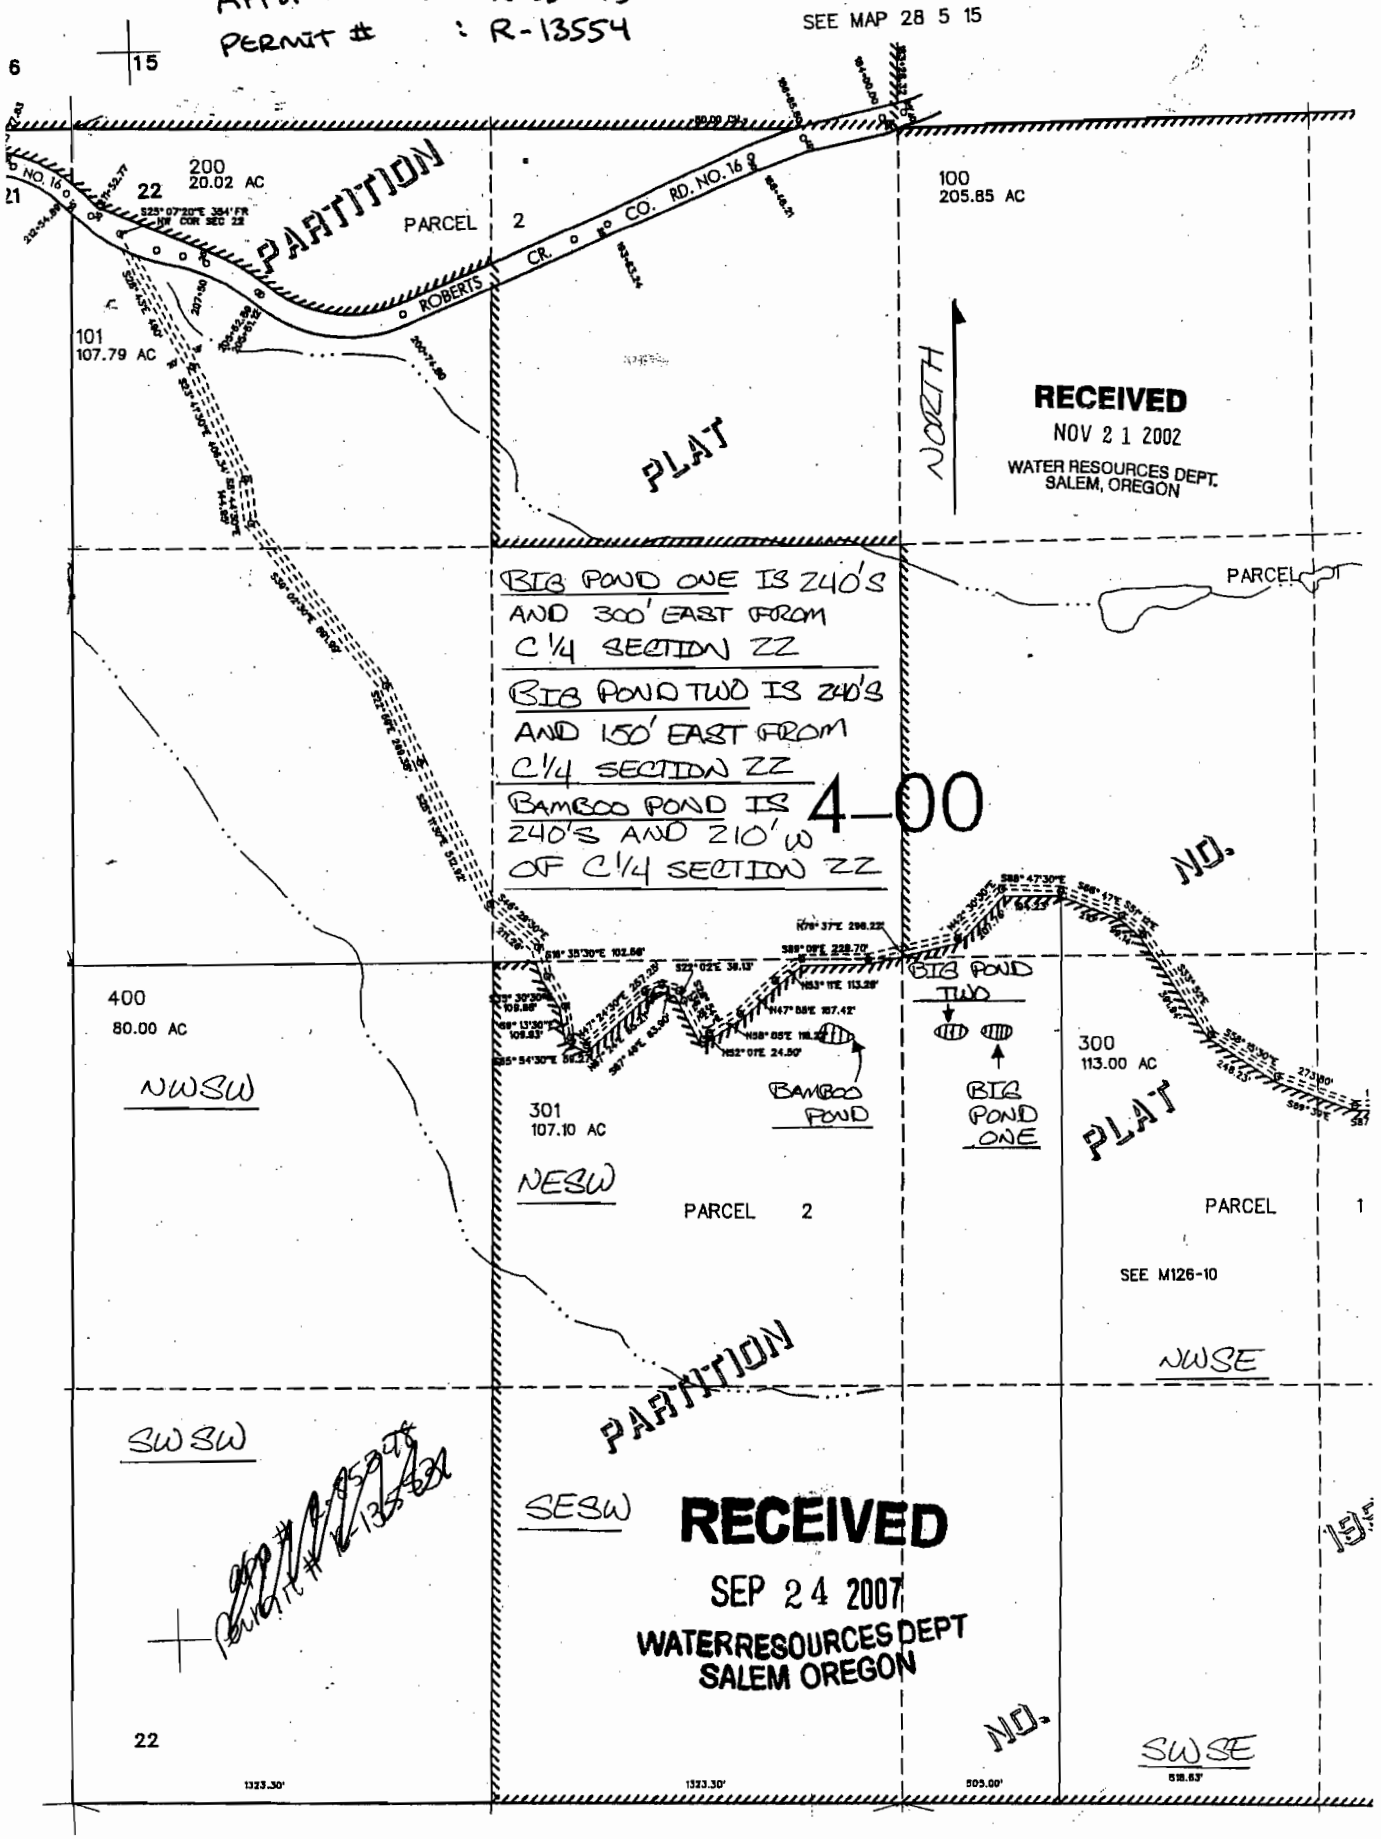
APPLICATION #: R-85349
PERMIT #: R-13554