


# CLAIM OF BENEFICIAL USE MAP

UNDER APPLICATION R-85396; PERMIT R-13574

SE1/4 SW1/4 SEC 9 T 22S R 42E W.M.

U.S.G.S. QUAD - KEENEY RIDGE, OREG. - 7 1/2'

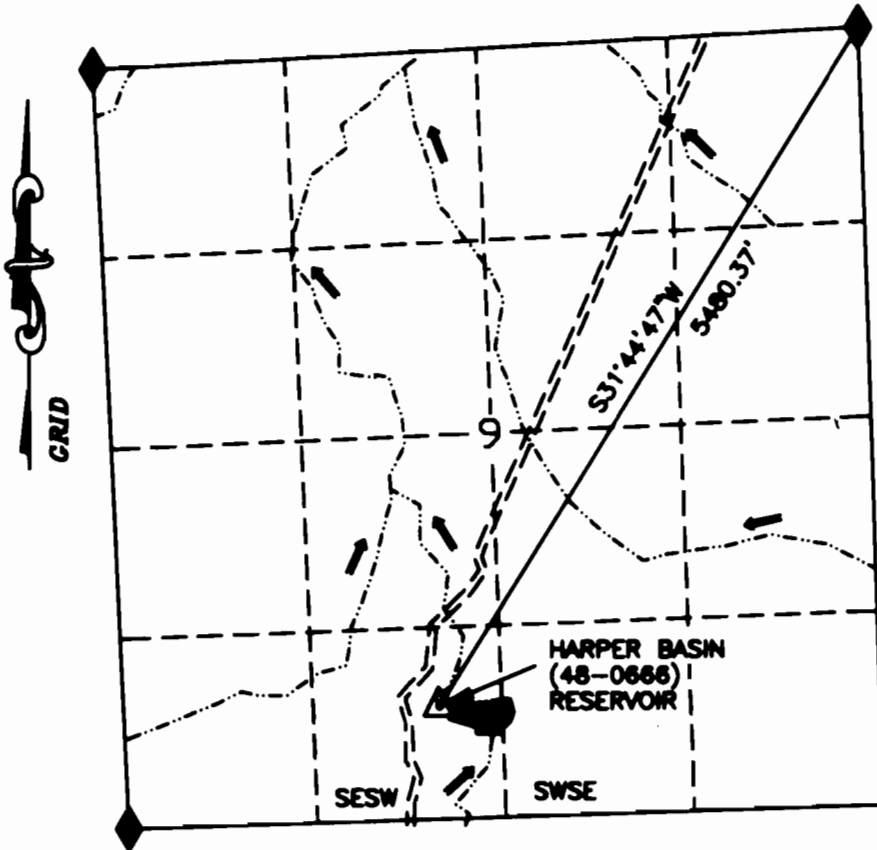

## LEGEND

- RESERVOIR
- ROAD
- CHANNEL
- FD SEC COR
- PROJECT MON.


**RECEIVED**

SEP 10 2006

WATER RESOURCES DEPT  
SALEM OREGON

## HARPER BASIN (48-0666) RESERVOIR

ASSESSORS MAP 22S42E  
TAX LOT. 200

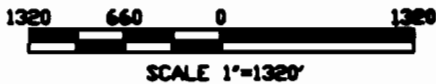

I, Charles E. Joy, Administrative Officer, Vale BLM agree to the findings of the CWRE and do submit this site report and map as my Claim of Beneficial Use of the water as provided under the terms and conditions of my Permit R-13574

*Charles E. Joy*



THIS MAP IS FOR THE PURPOSE OF LOCATING A WATER RIGHT AND IS NOT INTENDED TO PROVIDE LEGAL DIMENSIONS FOR LOCATION OF PROPERTY BOUNDARIES.

ACADEMIC  
SVG P HARPER-BASIN 2006

UNITED STATES DEPARTMENT OF THE INTERIOR BUREAU OF LAND MANAGEMENT DIVISION OF OPERATIONS VALE DISTRICT	
HARPER BASIN (48-0666) RESERVOIR	
DESIGNED: <i>Thomas R. J. [Signature]</i>	
REVIEWED: <i>[Signature]</i>	
APPROVED: <i>[Signature]</i>	
<small>2006 OPERATIONS AND PUBLIC SERVICES</small>	
DRAWN: CG	SCALE: 1"=1320'
DATE: 11/21/06	SHEET 1 OF 1
DRAWING NO. DR-03-9172.45-1273	