


# CLAIM OF BENEFICIAL USE MAP

UNDER APPLICATION R-85398 ; PERMIT R-13576

NW1/4 NE1/4 SEC 14 T 38 S R 43 E W.M.

U.S.G.S. QUAD - BATTLE MOUNTAIN, OREG. - 7 1/2'

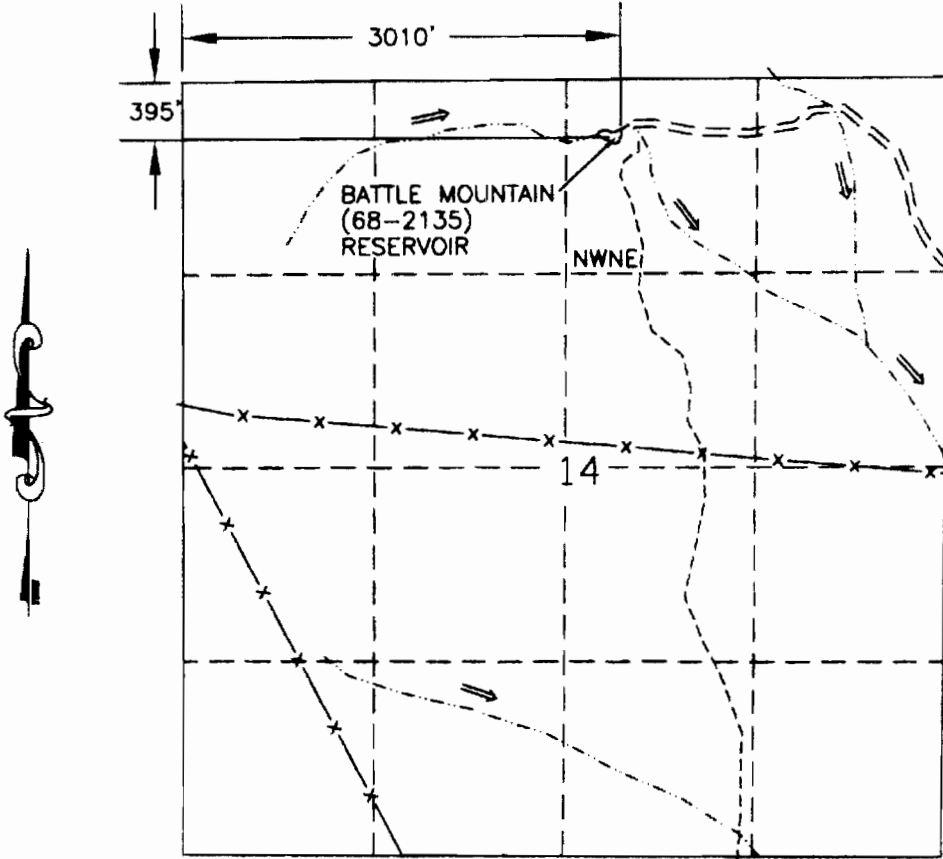

## LEGEND

- RESERVOIR
- ROAD
- CHANNEL
- FD SEC COR
- FENCE
- TRAIL


**RECEIVED**

SEP 10 2007

WATER RESOURCES DEPT  
SALEM OREGON

## BATTLE MOUNTAIN (68-2135) RESERVOIR

ASSESSOR MAP 38S43E  
TAX LOT NO. 100

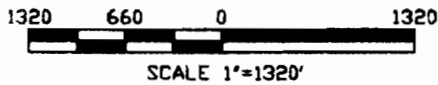

I, Charles E. Joy, Administrative Officer, Vale BLM agree to the findings of the CWRE and do submit this site report and map as my Claim of Beneficial Use of the water as provided under the terms and conditions of my Permit R-13576

*Charles E. Joy*



THIS MAP IS FOR THE PURPOSE OF LOCATING A WATER RIGHT AND IS NOT INTENDED TO PROVIDE LEGAL DIMENSIONS FOR LOCATION OF PROPERTY BOUNDARIES.

ACAD2006  
DVG FILE BATTLEMTN-BEN

UNITED STATES DEPARTMENT OF THE INTERIOR BUREAU OF LAND MANAGEMENT DIVISION OF OPERATIONS VALE DISTRICT	
BATTLE MOUNTAIN (68-2135) RESERVOIR	
DESIGNED:	<i>James R. Patterson</i>
REVIEWED:	<i>Charles E. Joy</i>
APPROVED:	<i>Charles E. Joy</i> ADM OPERATIONS AND FIELD SERVICES
DRAWN: CG	SCALE: 1"=1320'
DATE: 10/23/06	SHEET 1 OF 1
DRAWING NO. DR-03-9172.45-1266	