


CLAIM OF BENEFICIAL USE MAP

UNDER APPLICATION R-85408; PERMIT R-13585

NE1/4 NE1/4 SEC 12 T 22 S R 38 E W.M.

U.S.G.S. QUAD - MONUMENT PEAK, OR - 7 1/2'

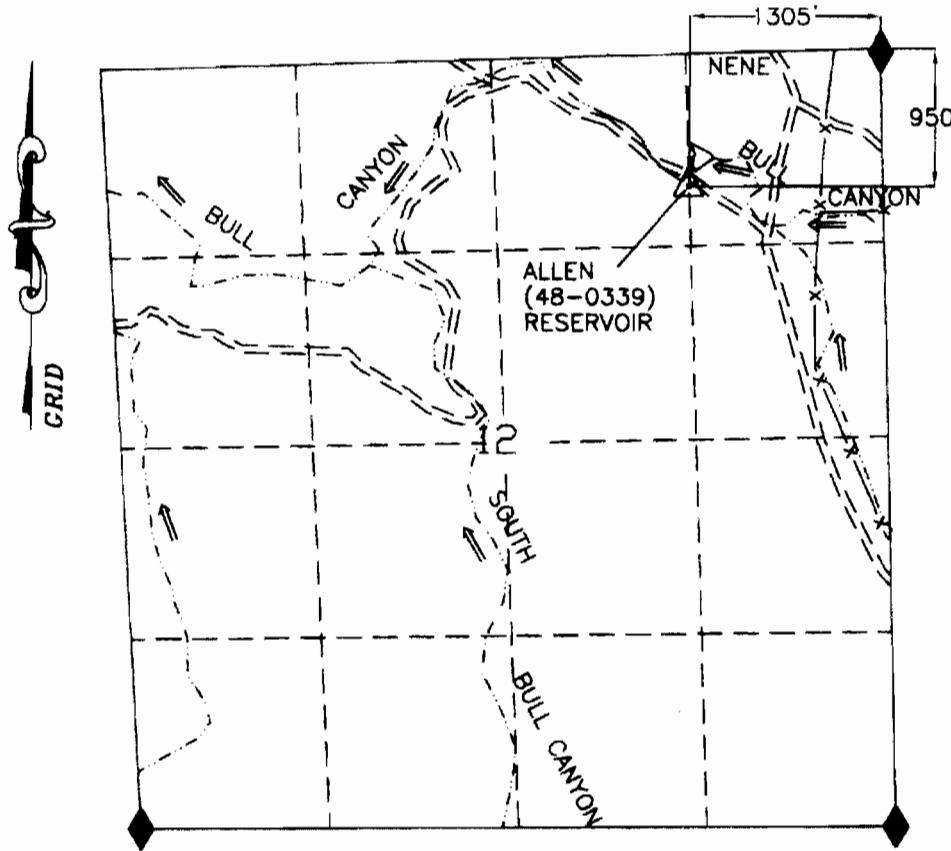


LEGEND

- RESERVOIR
- ROAD
- CHANNEL
- FD SEC COR
- PROJECT MON.
- FENCE

ALLEN (48-0339) RESERVOIR

ASSESSOR MAP 22S38E
TAX LOT NO. 100

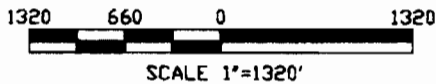

I, Charles E. Joy, Administrative Officer, Vale BLM agree to the findings of the CWRE and do submit this site report and map as my Claim of Beneficial Use of the water as provided under the terms and conditions of my Permit R-13585

Charles E. Joy



THIS MAP IS FOR THE PURPOSE OF LOCATING A WATER RIGHT AND IS NOT INTENDED TO PROVIDE LEGAL DIMENSIONS FOR LOCATION OF PROPERTY BOUNDARIES.

ACAD2006
DWG FILE: ALLEN-BENE

RECEIVED
SEP 10 2007
WATER RESOURCES DEPT
SALEM, OREGON

UNITED STATES DEPARTMENT OF THE INTERIOR BUREAU OF LAND MANAGEMENT DIVISION OF OPERATIONS VALE DISTRICT	
ALLEN (48-0339) RESERVOIR	
DESIGNED:	<i>Chris [Signature]</i>
REVIEWED:	<i>[Signature]</i>
APPROVED:	<i>Chris [Signature]</i>
<small>ADM OPERATIONS AND FIELD SERVICES</small>	
DRAWN: CG	SCALE: 1"=1320'
DATE: 10/23/06	SHEET 1 OF 1
DRAWING NO. OR-03-9172.45-1264	