


CLAIM OF BENEFICIAL USE MAP

UNDER APPLICATION R-85134; PERMIT R-13599

NE1/4SW1/4 SEC 14 T 40S R 43E W.M.

U.S.G.S. QUAD - TENMILE RANCH, OREG. - 7 1/2'

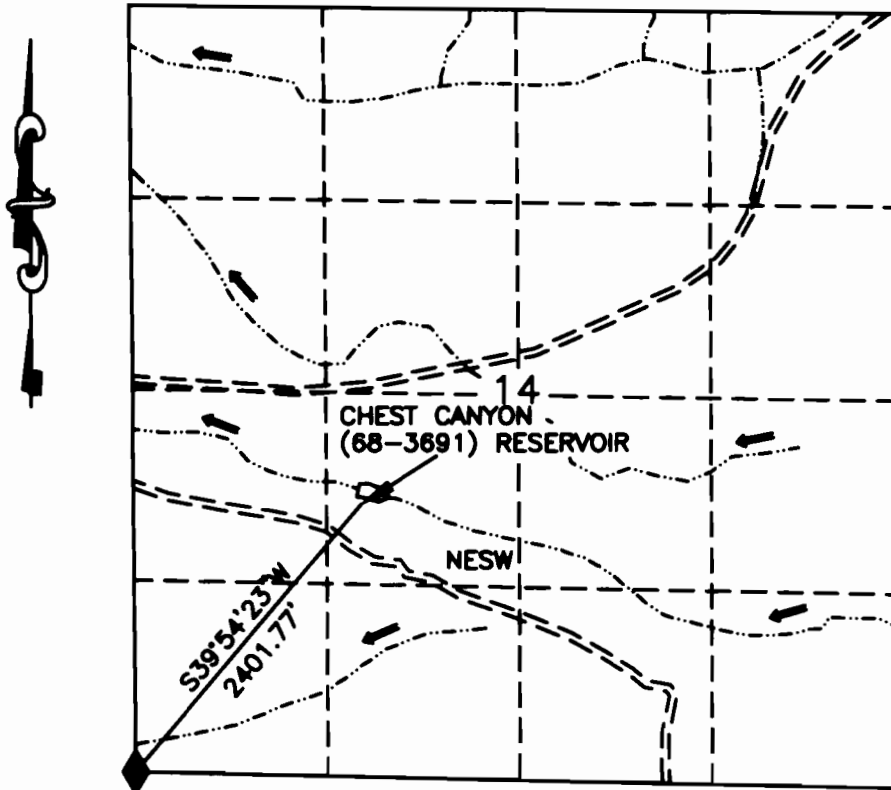

LEGEND

- RESERVOIR
- ROAD
- CHANNEL
- FD SEC COR

RECEIVED

SEP 10 2007

WATER RESOURCES DEPT
SALEM, OREGON

CHEST CANYON (68-3691) RESERVOIR

ASSESSOR MAP 40S43E.PDF
TAX LOT 100

1320 660 0 1320
SCALE 1"=1320'

I, Charles E. Joy, Administrative Officer, Vale BLM agree to the findings of the CWRE and do submit this site report and map as my Claim of Beneficial Use of the water as provided under the terms and conditions of my Permit R-13599

Charles E. Joy



THIS MAP IS FOR THE PURPOSE OF LOCATING A WATER RIGHT AND IS NOT INTENDED TO PROVIDE LEGAL DIMENSIONS FOR LOCATION OF PROPERTY BOUNDARIES.

ACAD2008
DWG FILE: CHEST-BENE

UNITED STATES DEPARTMENT OF THE INTERIOR BUREAU OF LAND MANAGEMENT DIVISION OF OPERATIONS VALE DISTRICT	
CHEST CANYON (68-3691) RESERVOIR	
DESIGNED: <u>[Signature]</u>	
REVIEWED: <u>[Signature]</u>	
APPROVED: <u>[Signature]</u>	
DRAWN: CG	SCALE: 1"=1320'
DATE: 11/20/06	SHEET 1 OF 1
DRAWING NO. OR-03-9*172.45-1269	