


CLAIM OF BENEFICIAL USE MAP

UNDER APPLICATION R-85136; PERMIT R-13600

NE1/4 SE1/4 SEC 10 T 39S R 43E W.M.

U.S.G.S. QUAD - JACKSON SUMMIT, OREG. - 7 1/2'

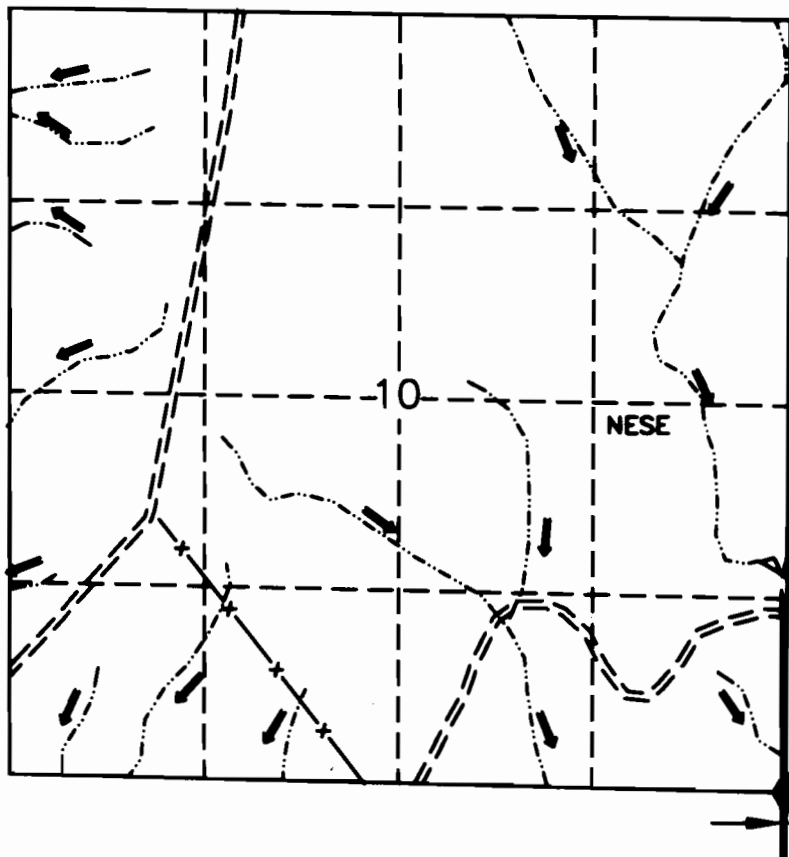

LEGEND

- RESERVOIR
- ROAD
- CHANNEL
- FD SEC COR
- FENCE

JACKSON CREEK
(68-0589)
RESERVOIR

1470'

30'

RECEIVED

SEP 10 2007

WATER RESOURCES DEPT
SALEM, OREGON

JACKSON CREEK (68-0589) RESERVOIR

ASSESSORS MAP 39S43E
TAX LOT 100

1320 660 0 1320
SCALE 1"=1320'

I, Charles E. Joy, Administrative Officer, Vets BLM
agree to the findings of the CWRE and do submit
this site report and map as my Claim of Beneficial
Use of the water as provided under the terms and
conditions of my Permit R-13600

Charles E. Joy



THIS MAP IS FOR THE PURPOSE OF LOCATING
A WATER RIGHT AND IS NOT INTENDED TO
PROVIDE LEGAL DIMENSIONS FOR LOCATION
OF PROPERTY BOUNDARIES.

ACAD0000
DWG FILEBACKSONCR-BEN

UNITED STATES DEPARTMENT OF THE INTERIOR BUREAU OF LAND MANAGEMENT DIVISION OF OPERATIONS VALE DISTRICT	
JACKSON CREEK (68-0589) RESERVOIR	
DESIGNED: <i>Theresa J. [Signature]</i>	
REVIEWED: <i>Charles E. Joy</i>	
APPROVED: <i>Charles E. Joy</i>	
DRAWN: CG	SCALE: 1"=1320'
DATE: 11/21/06	SHEET 1 OF 1
DRAWING NO. OR-03-9172.45-1274	