


# CLAIM OF BENEFICIAL USE MAP

UNDER APPLICATION R-85400; PERMIT R-13578

NW1/4 NW1/4 SEC 20 T 19S R 46E W.M.

U.S.G.S. QUAD - CAIRO, OREG. - 7 1/2'

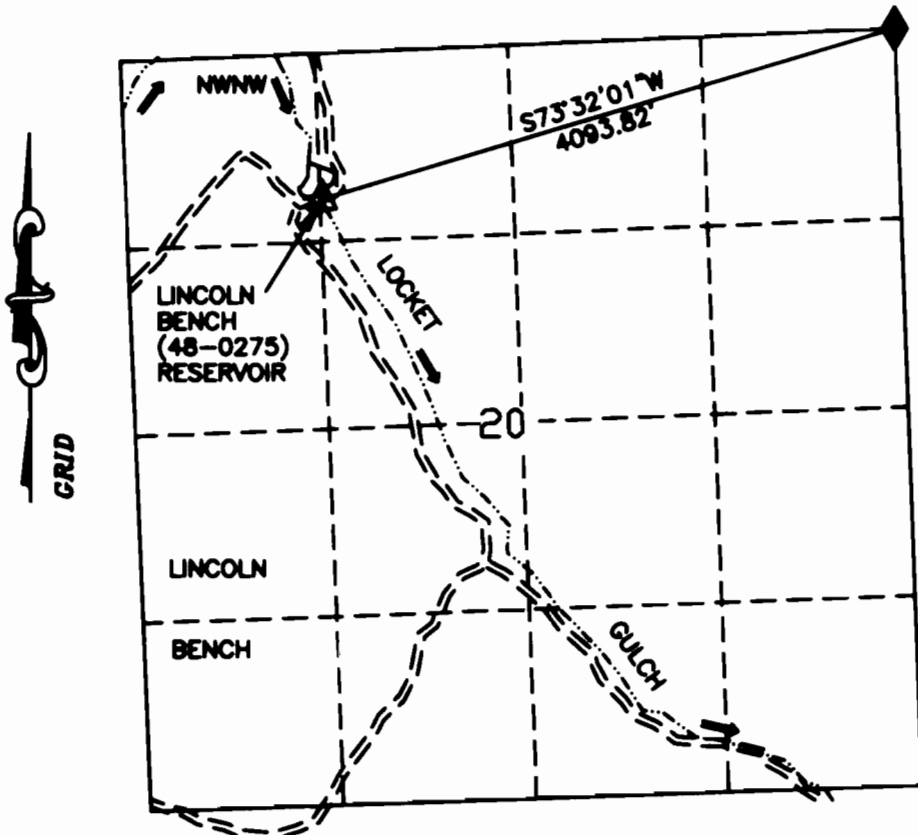


- LEGEND
- RESERVOIR
  - ROAD
  - CHANNEL
  - FD SEC COR
  - PROJECT MON.

**RECEIVED**  
SEP 10 2007

LINCOLN BENCH (45-0275) RESERVOIR WATER RESOURCES DEPT  
SALEM OREGON

ASSESSORS MAP 19S46E  
TAX LOT 4800

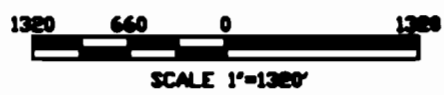

I, Charles E. Jay, Administrative Officer, Vale BLM agree to the findings of the CWRE and do submit this site report and map as my Claim of Beneficial Use of the water as provided under the terms and conditions of my Permit R-13578



THIS MAP IS FOR THE PURPOSE OF LOCATING A WATER RIGHT AND IS NOT INTENDED TO PROVIDE LEGAL DIMENSIONS FOR LOCATION OF PROPERTY BOUNDARIES.

UNITED STATES DEPARTMENT OF THE INTERIOR BUREAU OF LAND MANAGEMENT DIVISION OF OPERATIONS VALE DISTRICT	
LINCOLN BENCH (48--0275) RESERVOIR	
DESIGNED: <u>Deann R. [Signature]</u>	
REVIEWED: <u>[Signature]</u>	
APPROVED: <u>[Signature]</u>	
DRAWN: CG	SCALE: 1"=1320'
DATE: 11/21/06	SHEET 1 OF 1
DRAWING NO. DR-03-9172.45-1276	

