


CLAIM OF BENEFICIAL USE MAP

UNDER APPLICATION R-85154; PERMIT R-13632

NE1/4 SEC 22 T 40S R 43E W.M.

U.S.G.S. QUAD - TEN MILE RANCH, OREG. - 7 1/2'

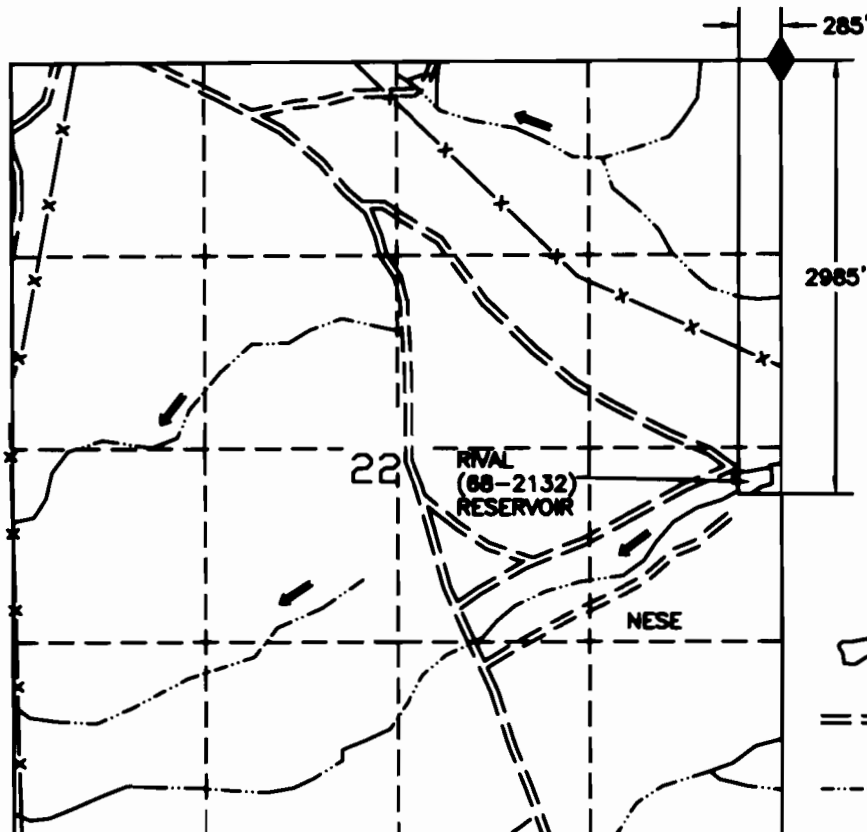

LEGEND

- RESERVOIR
- ROAD
- CHANNEL
- FD SEC COR
- FENCE


RECEIVED

OCT 01 2007

WATER RESOURCES DEPT.
SALEM, OREGON

RIVAL (68-2132) RESERVOIR

ASSESSOR MAP 40S43E
TAX LOT 100

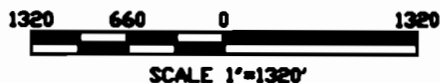

I, Charles E. Joy, Administrative Officer, Vale BLM agree to the findings of the CWRE and do submit this site report and map as my Claim of Beneficial Use of the water as provided under the terms and conditions of my Permit R-13632

[Signature]

THIS MAP IS FOR THE PURPOSE OF LOCATING A WATER RIGHT AND IS NOT INTENDED TO PROVIDE LEGAL DIMENSIONS FOR LOCATION OF PROPERTY BOUNDARIES.



ACAS
DWG FILE: RIVAL-BENE

UNITED STATES DEPARTMENT OF THE INTERIOR BUREAU OF LAND MANAGEMENT DIVISION OF OPERATIONS VALE DISTRICT	
RIVAL (68-2132) RESERVOIR	
DESIGNED: <i>[Signature]</i>	
REVIEWED: <i>[Signature]</i>	
APPROVED: <i>[Signature]</i>	
DRAWN: CG	
DATE: 11/22/06	SCALE: 1"=1320'
SHEET 1 OF 1	
DRAWING NO. DR-03-9172.45-1281	