
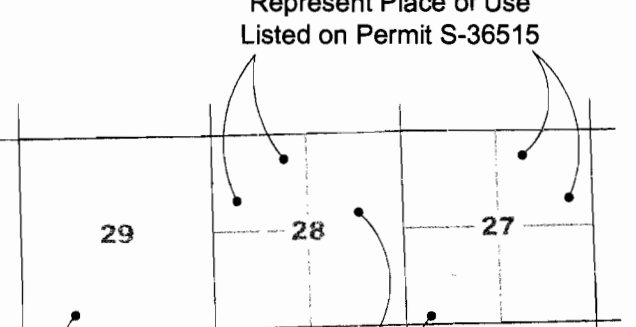


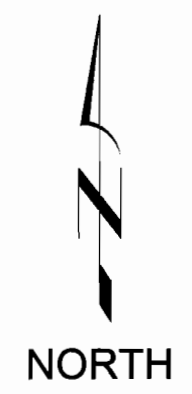
5,280' 0' 5,280' 10,560'
SCALE: 1" = 5,280'

Notes
1. This map was prepared for the purpose of identifying the location of water rights only and is not intended to provide legal dimensions or locations of property ownership lines.

Explanation
 POD - Opal Springs, Permit S-36515
1,215.44 ft North and 1,939.8 ft West from the East 1/4 Corner of Section 33 Being Within SW-NE of Section 33 Township 12.S, Range 12.E, W.M.

Areas With 1/4-1/4's Gridded Represent Place of Use Listed on Permit S-36515

 Areas Within Section Not Gridded Are Not Listed As Place of Use on Permit S-36515
 Single "X" 1/4-1/4's Represent Single 1/4-1/4 Not Listed As Place of Use on Permit S-36515.

Claim of Beneficial Use - Permit S-36515
Service Area Boundary
Deschutes Valley Water District
Deschutes County, Oregon



NO.	DATE	BY	REVISIONS

PROJECT NO:	450-108	DATE:	May 2007	FIGURE 1
DESIGNED BY:	M.Parle	DRAWN BY:	S.Schenk	