


CLAIM OF BENEFICIAL USE MAP

UNDER APPLICATION R-85407; PERMIT R-14021

NE1/4 SW1/4 SEC 10 T 25S R 45E W.M.


U.S.G.S. QUAD - THREE FINGERS ROCK, OREG. - 7 1/2'

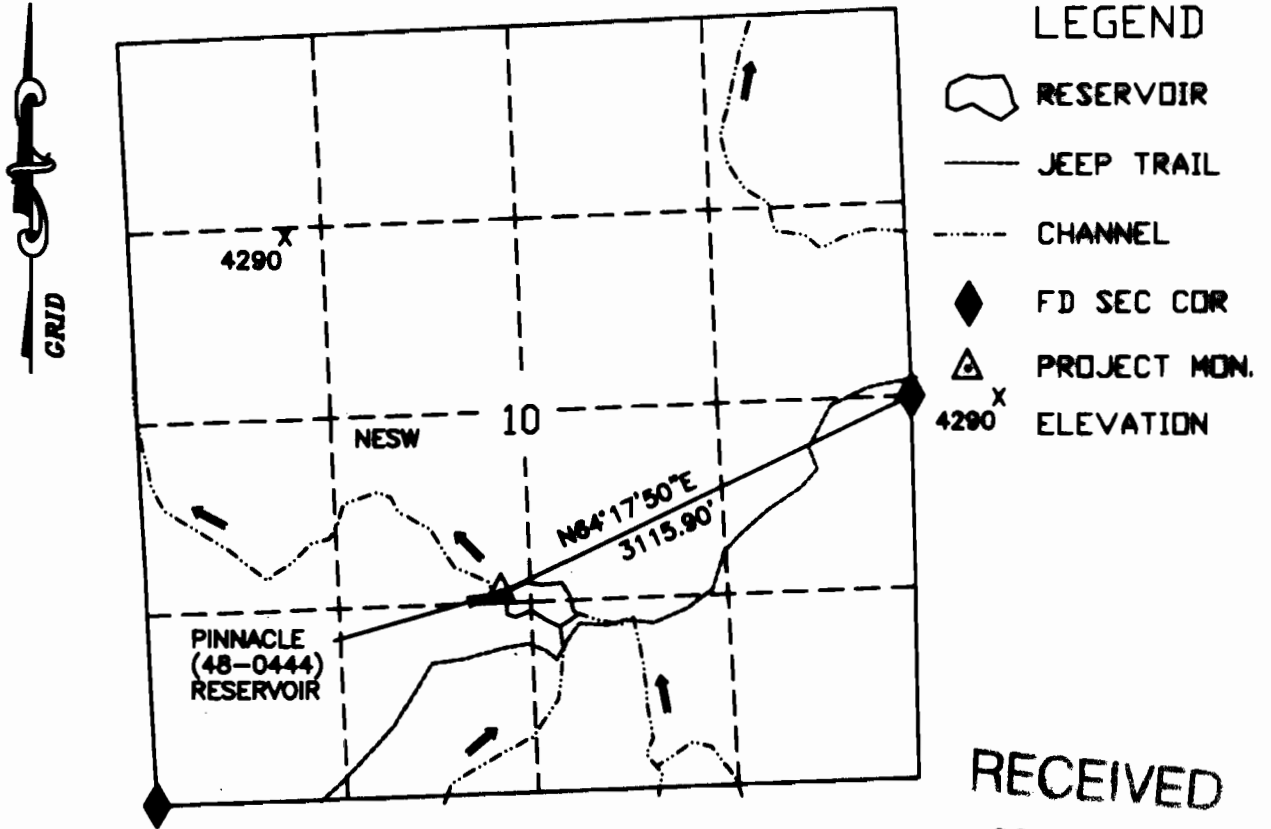

RECEIVED
OCT 11 2007
WATER RESOURCES DEPT.
SALEM, OREGON

PINNACLE (48-0444) RESERVOIR

ASSESSORS MAP 25S45E
TAX LOT 100

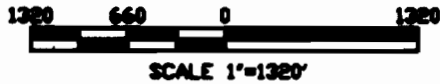

I, Charles E. Joy, Administrative Officer, Vale BLM agree to the findings of the CWRE and do submit this site report and map as my Claim of Beneficial Use of the water as provided under the terms and conditions of my Permit R-14021

Charles E. Joy



THIS MAP IS FOR THE PURPOSE OF LOCATING A WATER RIGHT AND IS NOT INTENDED TO PROVIDE LEGAL DIMENSIONS FOR LOCATION OF PROPERTY BOUNDARIES.

ACAD 100
DWG FILE: Pinnacle-Bene

UNITED STATES DEPARTMENT OF THE INTERIOR BUREAU OF LAND MANAGEMENT DIVISION OF OPERATIONS VALE DISTRICT	
PINNACLE (48-0444) RESERVOIR	
DESIGNED: <i>Thomas R. ...</i>	
REVIEWED: <i>Charles E. Joy</i>	
APPROVED: <i>Charles E. Joy</i>	
DRAWN: CG	SCALE: 1"=1320'
DATE: 11/22/06	SHEET 1 OF 1
DRAWING NO. OR-03-9172.43-1279	