

019-01

92-PO22

PARTITION

RECEIVED

NOV 13 2007

WATER RESOURCES DEPT
SALEM, OREGON

RECEIVED

MAR 12 2007

WATER RESOURCES DEPT
SALEM, OREGON


T 17 S R 1 W

Section 32.1

NW and SW 1/4s of NE 1/4

1" = 200'

4

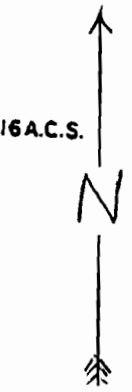

APPROX.
CTR. SEC.

N. 89° 55' 48" E. 130.77'

CS. Stone
E.E. N.E. 1812
corner of
ac. 32.
P. 97.
Stone Erroneously
Based on Center
of Section

Pond Locations from Center 1/4 Corner

1	1270' N	440' E
2	1100' N	400' E
3	830' N	600' E
4	100' N	800' E
5	500' N	970' E

SEE MAP 17 01 32 4

R86802/R14479