


T.10S., R.2W., W.M.

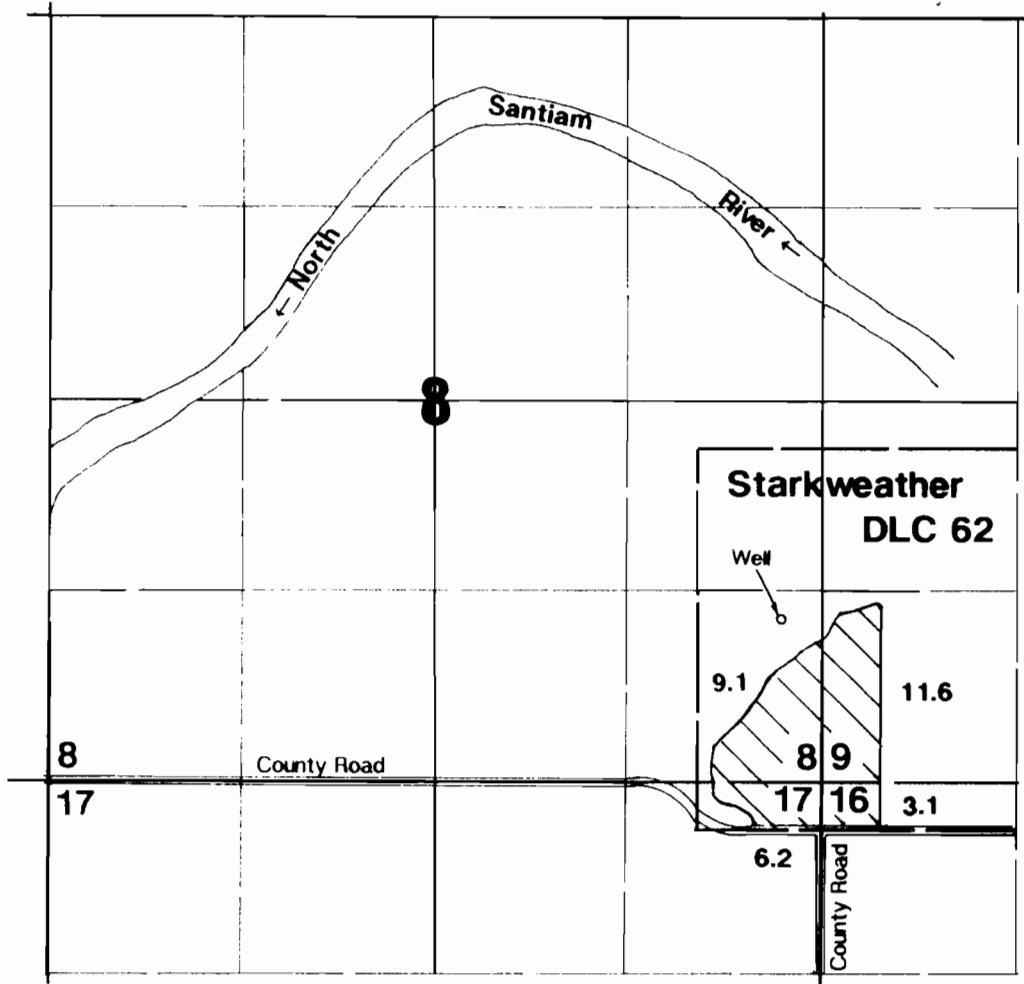

Well located 1125'N & 260'W from SE corner Section 8.

Final Proof Survey

Application #: G-12274 Permit #: G-11163

In Name Of

Kenneth Cunningham

Surveyed **August 22, 1993** by JM Schuette

THIS MAP WAS PREPARED FOR THE PURPOSE OF IDENTIFYING THE LOCATION OF A WATER RIGHT ONLY AND IS NOT INTENDED TO PROVIDE LEGAL DIMENSIONS OR LOCATION OF PROPERTY OWNERSHIP LINES.

