


T. 10 S., R 23 E., W. M.

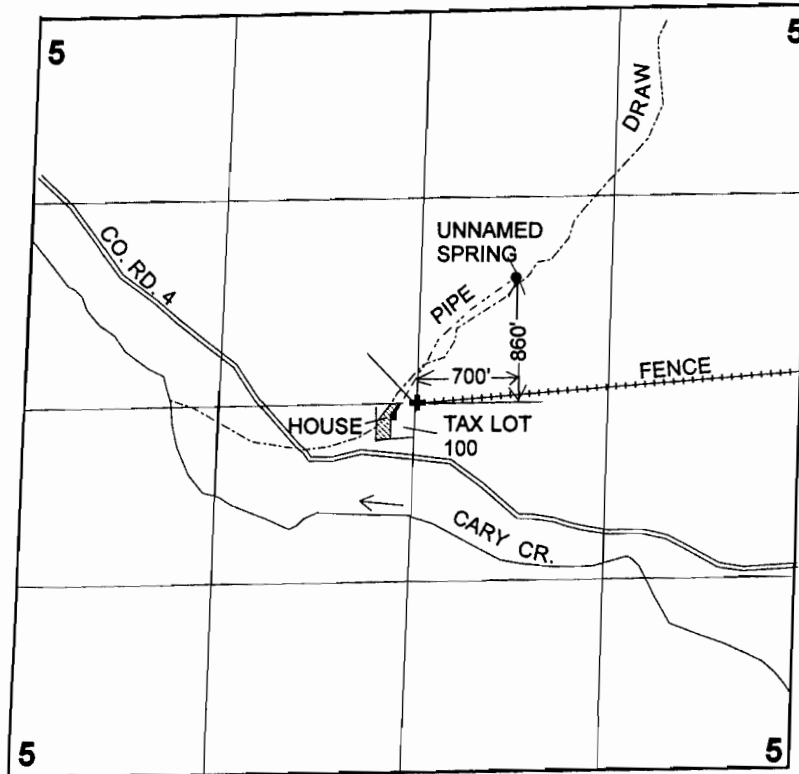

1" = 1320'

FINAL PROOF SURVEY

UNDER

Application No. 59201 Permit No. 44678

**IN THE NAME OF
RICHARD STEPHENS**

Surveyed: June 28, 2001 by: J. Miller