


CLAIM OF BENEFICIAL USE MAP

UNDER APPLICATION R-84304; PERMIT R-13651


GOV'T. LOT 1 SEC 31 T 27S R 43E W.M.

U.S.G.S. QUAD - JORDAN CRATERS NORTH, OREG. 7 1/2'

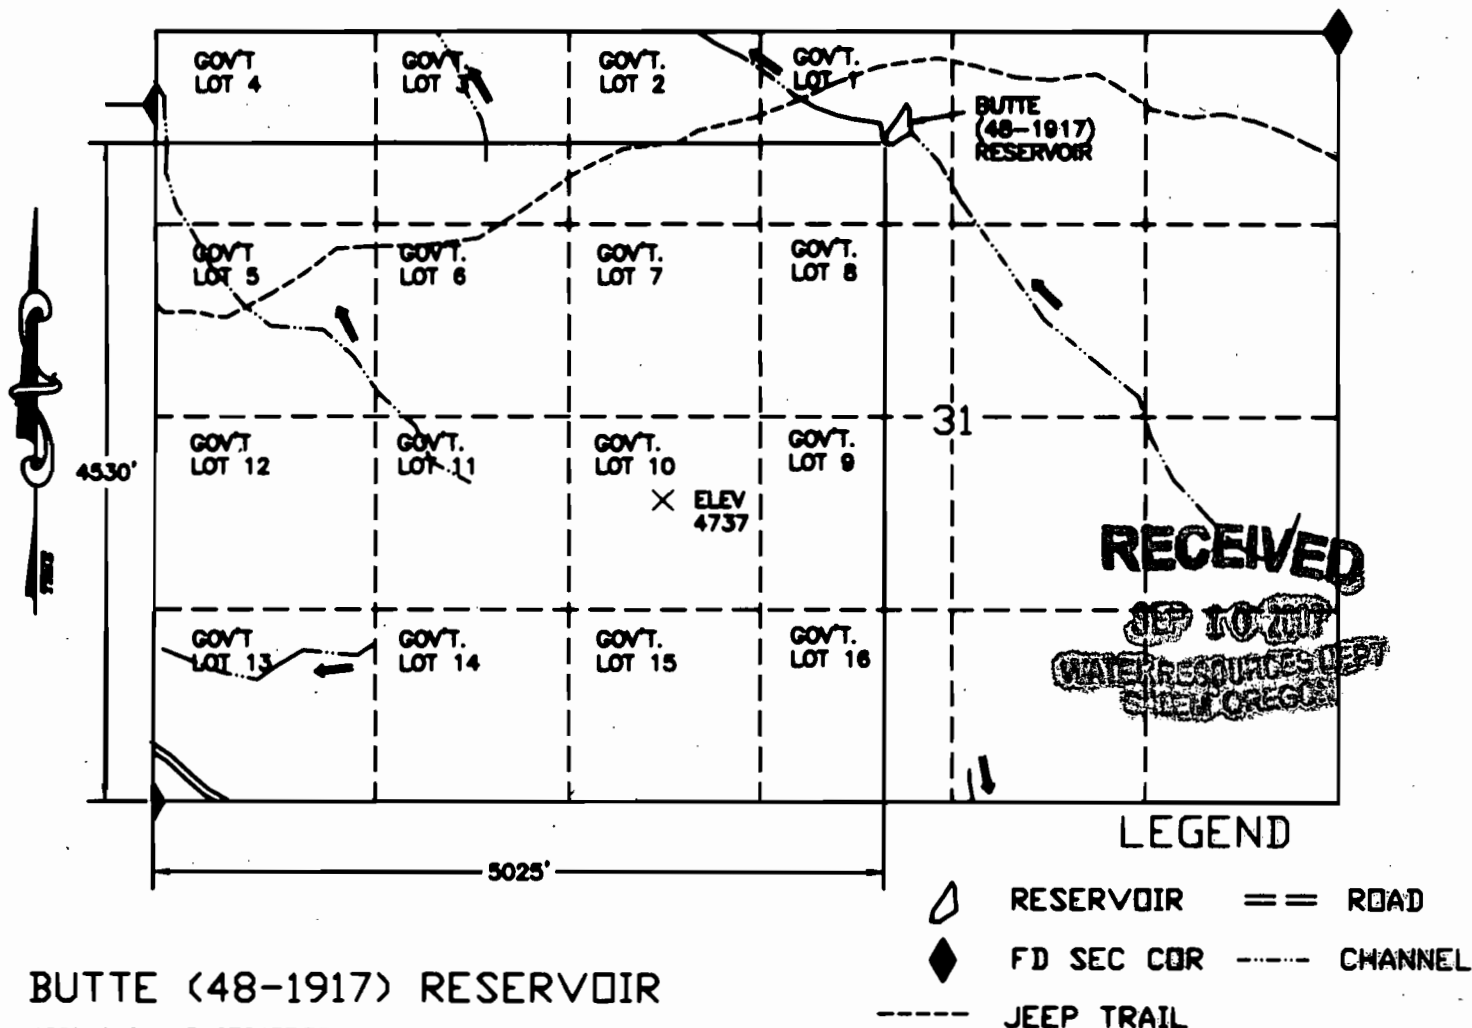

BUTTE (48-1917) RESERVOIR

ASSESSOR MAP 27S43E.PDF
TAX LOT 100

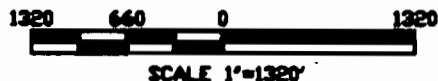

I, Charles E. Joy, Administrative Officer, Vale BLM agree to the findings of the CWRE and do submit this site report and map as my Claim of Beneficial Use of the water as provided under the terms and conditions of my Permit R-13651



THIS MAP IS FOR THE PURPOSE OF LOCATING A WATER RIGHT AND IS NOT INTENDED TO PROVIDE LEGAL DIMENSIONS FOR LOCATION OF PROPERTY BOUNDARIES.

ACADEMIC
DVG FILE BUTTE-BONE

UNITED STATES DEPARTMENT OF THE INTERIOR BUREAU OF LAND MANAGEMENT DIVISION OF OPERATIONS VALE DISTRICT	
BUTTE (48-1917) RESERVOIR	
DESIGNED: <u>[Signature]</u>	
REVIEWED: <u>[Signature]</u>	
APPROVED: <u>[Signature]</u>	
DRAWN: CG	SCALE: 1"=1320'
DATE: 11/20/06	SHEET 1 OF 1
DRAWING NO. DR-03-9172.45-1268	