


CLAIM OF BENEFICIAL USE MAP

UNDER APPLICATION R-85279; PERMIT R-13516

NE1/4 NE1/4 SEC 18 T 22S R 39E WM

U.S.G.S. QUAD - MONUMENT PEAK, OREG. - 7 1/2'

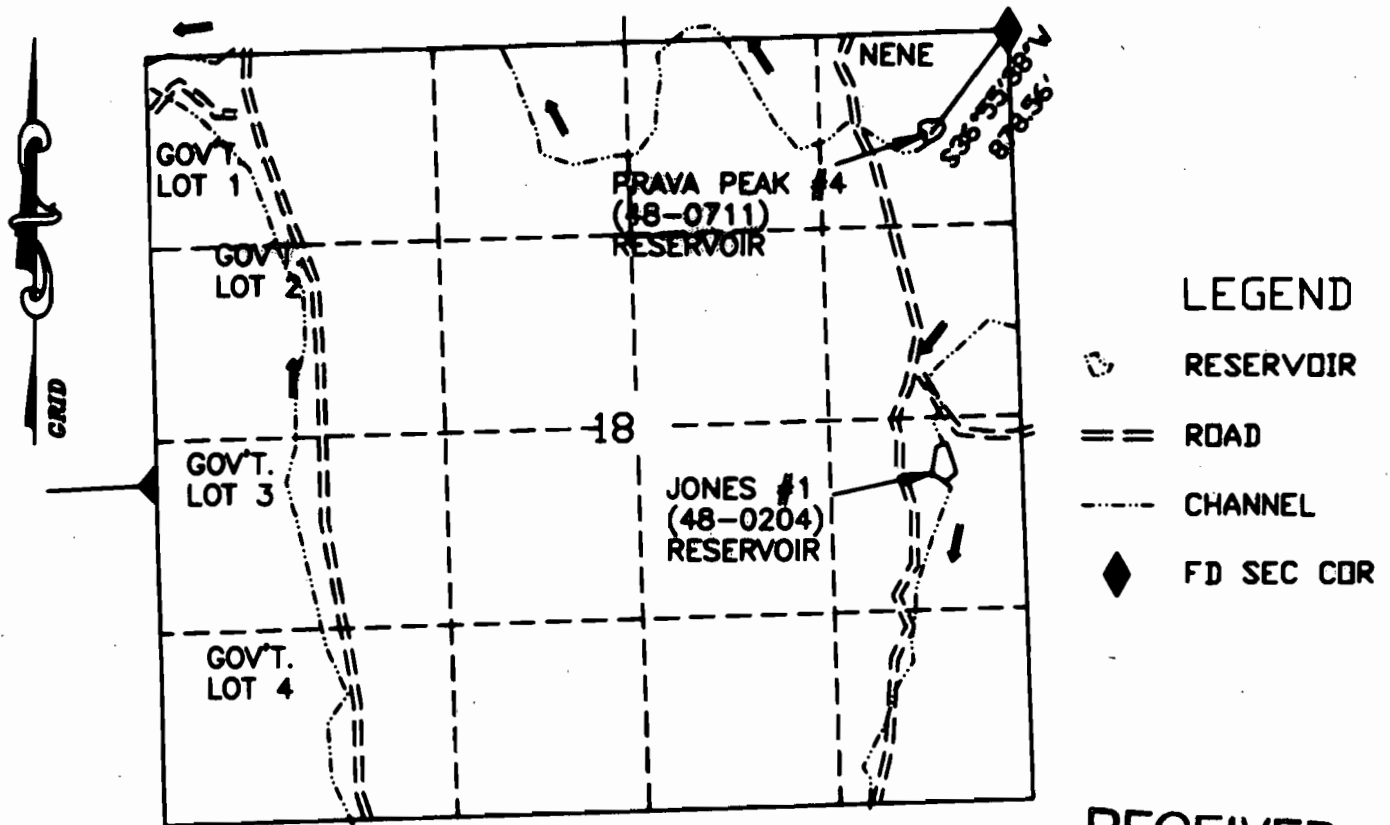

RECEIVED


OCT 01 2007

PRAVA PEAK #4 (48-0711) RESERVOIR

WATER RESOURCES DEPT.
SALEM, OREGON

ASSESSORS MAP 22S39E

TAX LOT 200

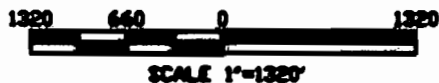

I, Charles E. Cox, Administrative Officer, Vale BLM agree to the findings of the CBE and do submit this site report and map as my Claim of Beneficial Use of the water as provided under the terms and conditions of my Permit R-13516

Charles E. Cox



THIS MAP IS FOR THE PURPOSE OF LOCATING A WATER RIGHT AND IS NOT INTENDED TO PROVIDE LEGAL DIMENSIONS FOR LOCATION OF PROPERTY BOUNDARIES.

RECEIVED
BOS FIELD PRAVA-2006

UNITED STATES DEPARTMENT OF THE INTERIOR BUREAU OF LAND MANAGEMENT DIVISION OF OPERATIONS VALE DISTRICT	
PRAVA PEAK #4 (48-0711) RESERVOIR	
DESIGNED	<u>[Signature]</u>
REVIEWED	<u>[Signature]</u>
APPROVED	<u>[Signature]</u>
DRAWN	CG
DATE	11/22/06
DRAWING NO.	DR-03-9172.43-1280
SCALE	1"=1320'
SHEET	1 OF 1