


CLAIM OF BENEFICIAL USE MAP

UNDER APPLICATION R-85277; PERMIT R-13514

SE1/4 NE1/4 SEC 23 T 17S R 41E WM

U.S.G.S. QUAD - BUCKBRUSH CREEK, OREG. - 7 1/2'

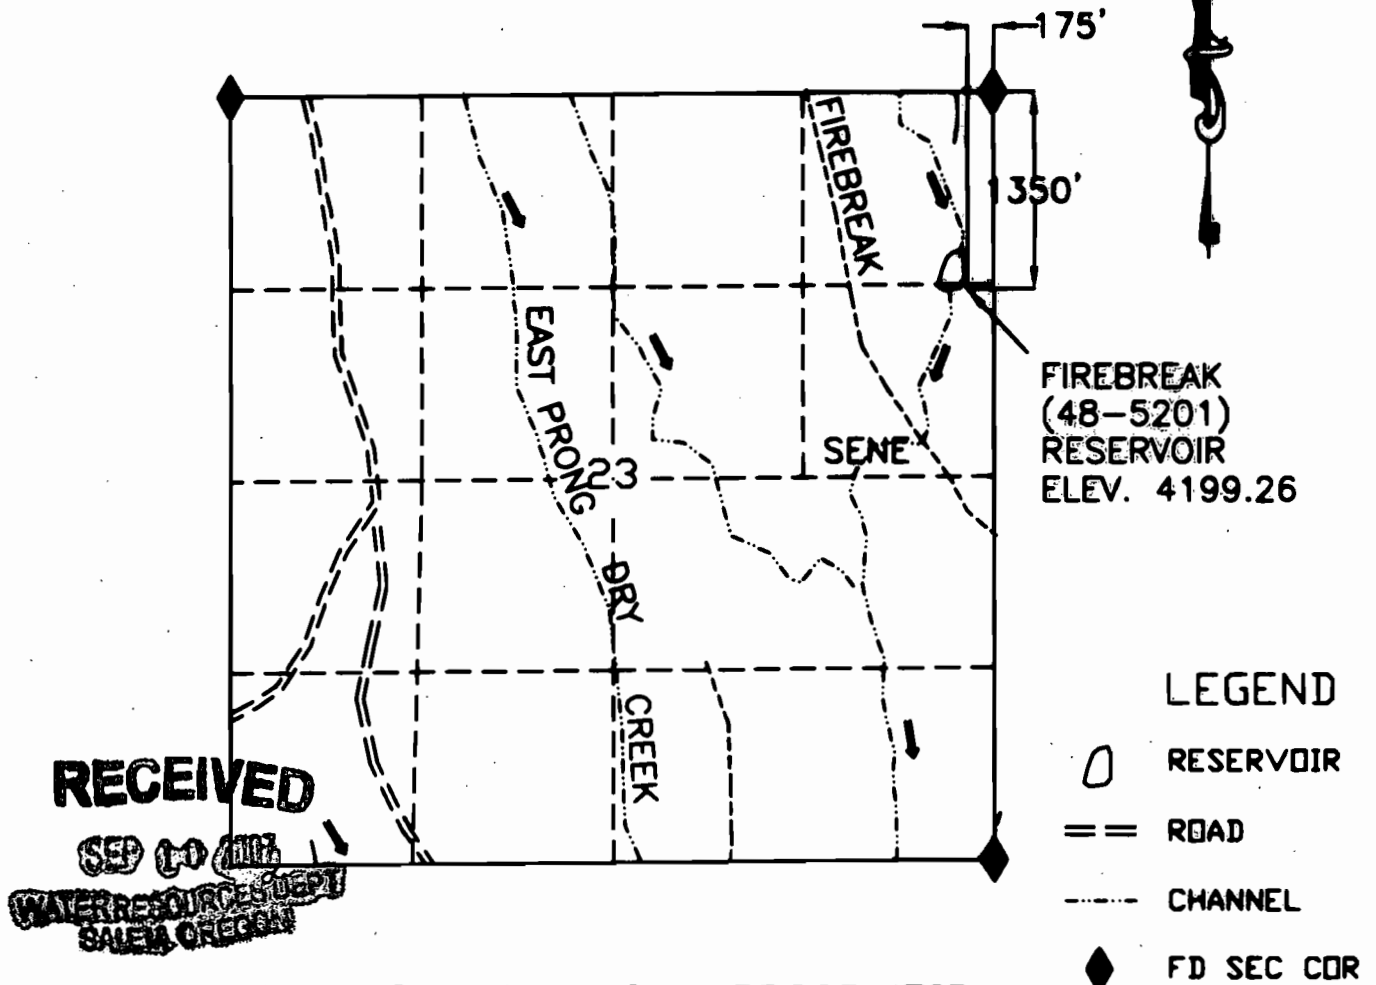

LAT 44°04'18.69843"
LONG 117°38'51.02431"

1320 660 0 1320
SCALE 1"=1320'

I, Charles E. Joz, Administrative Officer, Vale BLM agree to the findings of the CWRE and do submit this site report and map as my Claim of Beneficial Use of the water as provided under the terms and conditions of my Permit R-13514



THIS MAP IS FOR THE PURPOSE OF LOCATING A WATER RIGHT AND IS NOT INTENDED TO PROVIDE LEGAL DIMENSIONS FOR LOCATION OF PROPERTY BOUNDARIES.

UNITED STATES DEPARTMENT OF THE INTERIOR BUREAU OF LAND MANAGEMENT DIVISION OF OPERATIONS VALE DISTRICT		
FIREBREAK (48-5201) RESERVOIR		
DESIGNED:		
REVIEWED:		
APPROVED:		
DRAWN:	CG	SCALE: 1"=1320'
DATE:	11/20/06	SHEET 1 OF 1
DRAWING NO. OR-03-9172.43-1270		