


# CLAIM OF BENEFICIAL USE MAP

UNDER APPLICATION R-85264; PERMIT R-13477

NE1/4 SW1/4 SEC 27 T 29S R 45E W.M.

U.S.G.S. QUAD - DOWNEY CANYON, OREG. - 7 1/2'

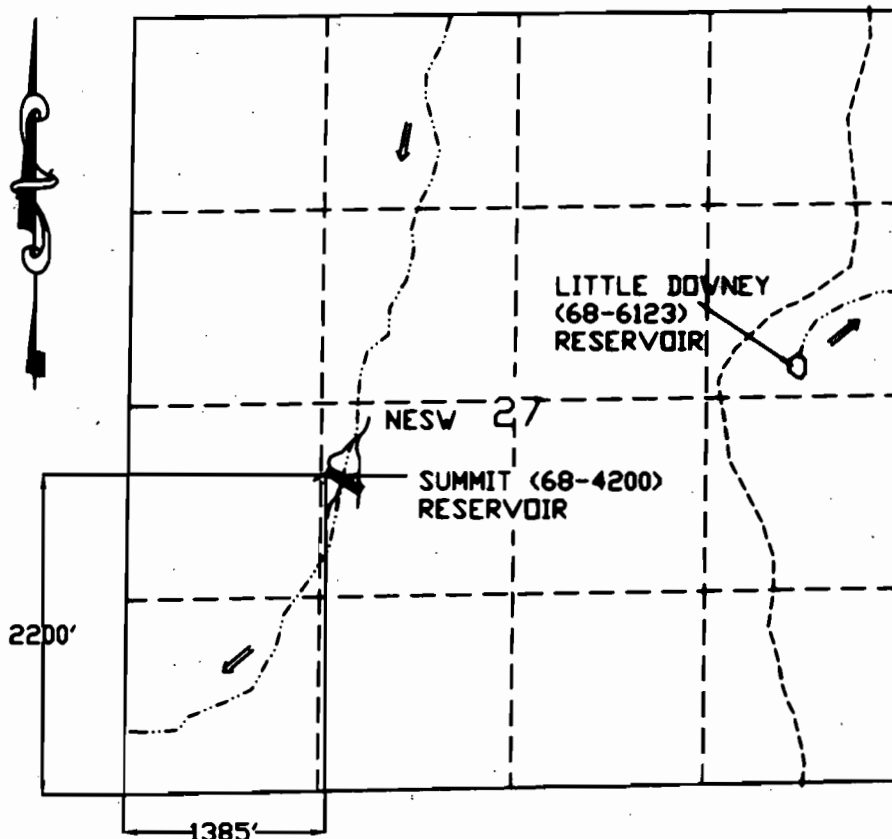


## LEGEND

- RESERVOIR NOT ON QUAD
- RESERVOIR SHOWN ON QUAD
- TRAIL
- CHANNEL

## SUMMIT (68-4200) RESERVOIR

ASSESSORS MAP 29S45E  
TAX LOT 700

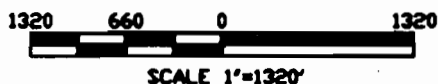

I, Charles E. Joy, Administrative Officer, Vale BLM agree to the findings of the CWRE and do submit this site report and map as my Claim of Beneficial Use of the water as provided under the terms and conditions of my Permit R-13477

THIS MAP IS FOR THE PURPOSE OF LOCATING A WATER RIGHT AND IS NOT INTENDED TO PROVIDE LEGAL DIMENSIONS FOR LOCATION OF PROPERTY BOUNDARIES.



ACAD2006

DWG FILE: SUMMIT4200-BEN

|   |                                |
|---|--------------------------------|
| UNITED STATES DEPARTMENT OF THE INTERIOR<br>BUREAU OF LAND MANAGEMENT<br>DIVISION OF OPERATIONS VALE DISTRICT |                                |
| SUMMIT (68-4200)<br>RESERVOIR                                                                                 |                                |
| DESIGNED:   | REVIEWED:                      |
| APPROVED:   | DATE: 11/22/06                 |
| DRAWN: CG   | SCALE: 1"=1320'                |
| SHEET 1 OF 1                                                                                                  | DRAWING NO. DR-03-9172.43-1286 |