


CLAIM OF BENEFICIAL USE MAP

UNDER APPLICATION R-85263 : PERMIT R-14024

SW1/4 SE1/4 SEC 24 T 22S R 42E W.M.

U.S.G.S. QUAD - KEENEY RIDGE, OREG. - 7 1/2'

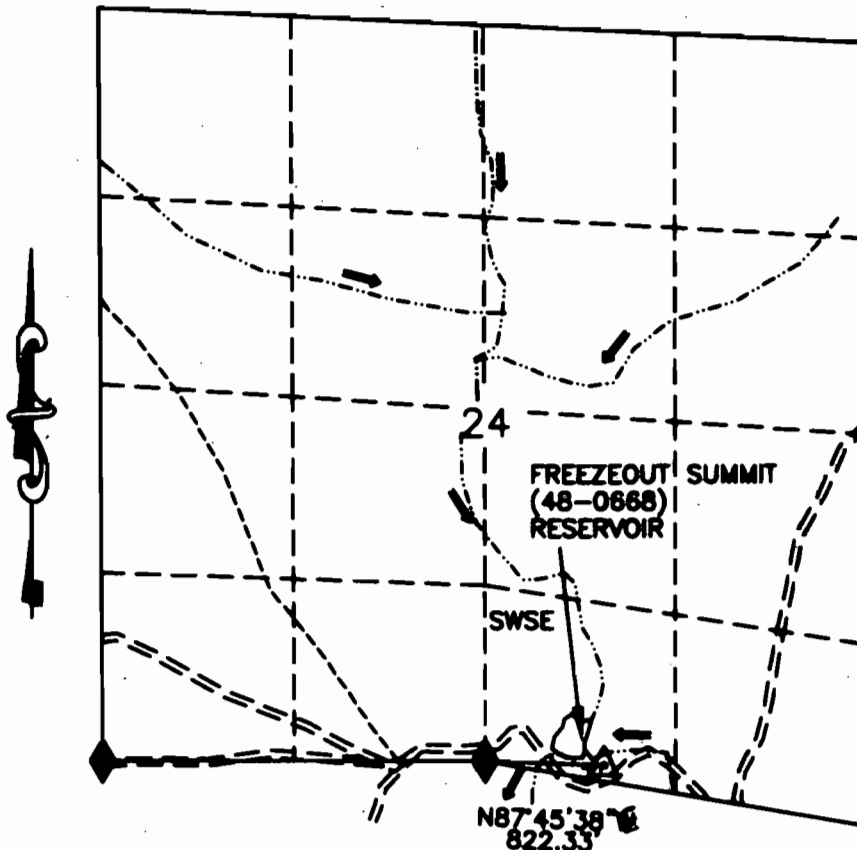

LEGEND

- RESERVOIR
- ROAD
- CHANNEL
- FD SEC COR
- TRAIL
- PROJECT MON. RESERVOIR


RECEIVED

SEP 10 2007

WATER RESOURCES UNIT
SALEM, OREGON

FREEZEOUT SUMMIT (48-0668) RESERVOIR

ASSESSORS PLAT 22S47E
TAX LOT 200

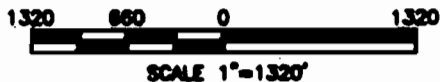

I, Charles E. Joy, Administrative Officer, Vale BLM agree to the findings of the CWRE and do submit this site report and map as my Claim of Beneficial Use of the water as provided under the terms and conditions of my Permit R-14024

Charles E. Joy



THIS MAP IS FOR THE PURPOSE OF LOCATING A WATER RIGHT AND IS NOT INTENDED TO PROVIDE LEGAL DIMENSIONS FOR LOCATION OF PROPERTY BOUNDARIES.

UNITED STATES DEPARTMENT OF THE INTERIOR BUREAU OF LAND MANAGEMENT DIVISION OF OPERATIONS VALE DISTRICT	
FREEZEOUT SUMMIT (48-0668) RESERVOIR	
DESIGNED: <i>James R. [Signature]</i>	
REVIEWED: <i>Nancy D. [Signature]</i>	
APPROVED: <i>Charles E. Joy</i>	
DRAWN: CG	SCALE: 1"=1320'
DATE: 11/20/06	SHEET 1 OF 1
DRAWING NO. OR-03-9172.45-1271	

ACAD2000

DWG FREEZE-SUM-BD