


FINAL PROOF
SEC 4, T 4 S, R 13 E, WM
COUNTY OF WASCO
STATE OF OREGON

PERMIT G - 11294
 JWG

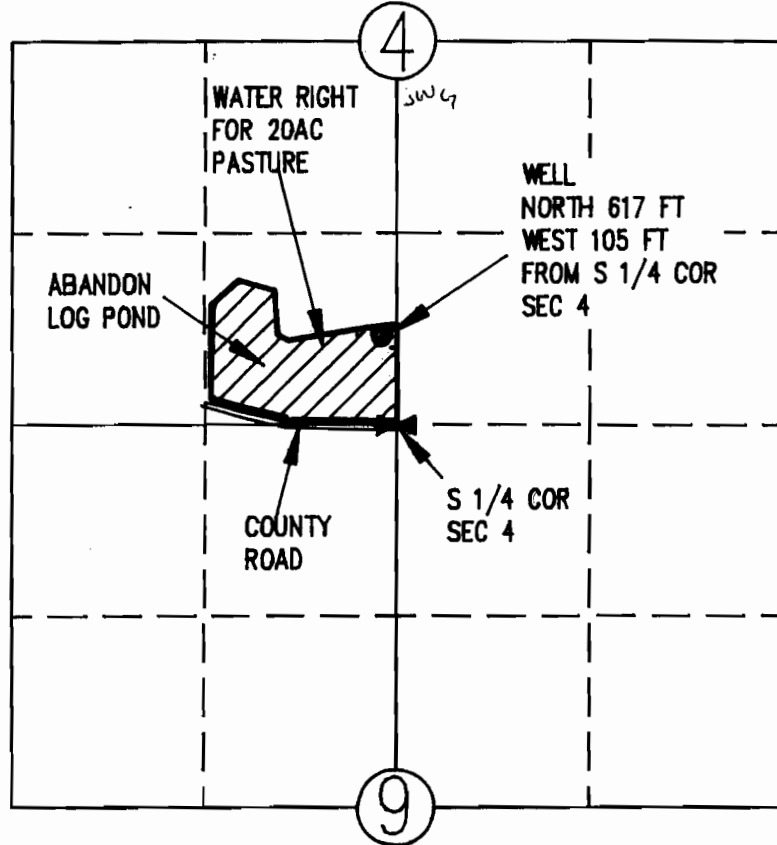

SCALE:
 4" = 1 MILE



CERTIFICATE:

I, ANTHONY C. KLEIN THE WITH-IN REGISTERED WATER RIGHTS EXAMINER DO HEREBY CERTIFY THAT THIS MAP WAS PREPARED BY ME AND IS FOR THE PURPOSE OF IDENTIFYING THE LOCATION OF THE WATER RIGHT ONLY AND HAS NO INTENT TO PROVIDE DIMENSIONS OR LOCATION OF PROPERTY OWNERSHIP LINES.

**WATER RIGHT
 FOR
 RANDY DELGO**



LAND SURVEYORS
 1109 Country Club Road
 Hood River, Oregon 97031
 Tele: (503)386-3322
 DATE: OCT 20, 1992
 JOB NO.: 90041

MODIFIED BY WLD - 1-24-08 JWG