



SCALE 1"=800'

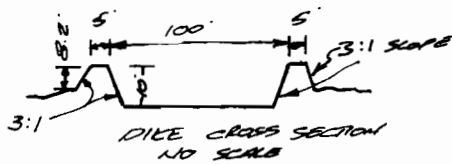

PUMP LOCATION:  
 435.57' NORTH &  
 207.06' WEST OF  
 N.E. COR. DLC #48  
 EL. TOP OF DIKE: 595.72 M.S.L.  
 EL. EXTERIOR TOE: 587.52 M.S.L.  
 EL. F.L. 6" P.V.C.: 593.54 M.S.L.

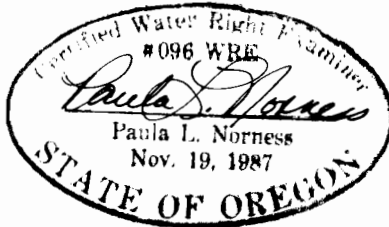

FINAL PROOF SURVEY  
 FOR  
 HEMEN-WAY FARMS  
 PERMIT # E11189  
 80254 SEARS ROAD  
 COTTAGE GROVE, OR 97424  
 BY

STEPHEN H. FORD INC.  
 1120 BAILEY HILL RD #5  
 EUGENE, OR 97402  
 (503) 344-1852

THE PREPARATION OF THE MAP  
 WAS FOR THE PURPOSE OF IDENTIFYING  
 THE LOCATION OF THE WATER RIGHT  
 ONLY. IT IS NOT INTENDED TO  
 PROVIDE LOCATION NOR DIMENSION  
 OF PROPERTY OWNERSHIP LINES.