

FINAL PROOF SURVEY

UNDER

APPLICATION NO. G-12475 PERMIT NO. G-13071

IN THE NAME OF

GEORGE HORNING OF HORNING ENTERPRISES INC.

RESURVEYED MARCH 9, 1991, BY J. EDWARD HENRICKS

SCALE: 1"=1320'-0"

ORIGINAL PERMIT NO. 46047

IN

WEST HALF OF SECTION 24


T.14 S., R.5 W., W.M.

BENTON COUNTY, OREGON

RECEIVED

MAR 17 1998


WATER RESOURCES DE
SALEM, OREGON

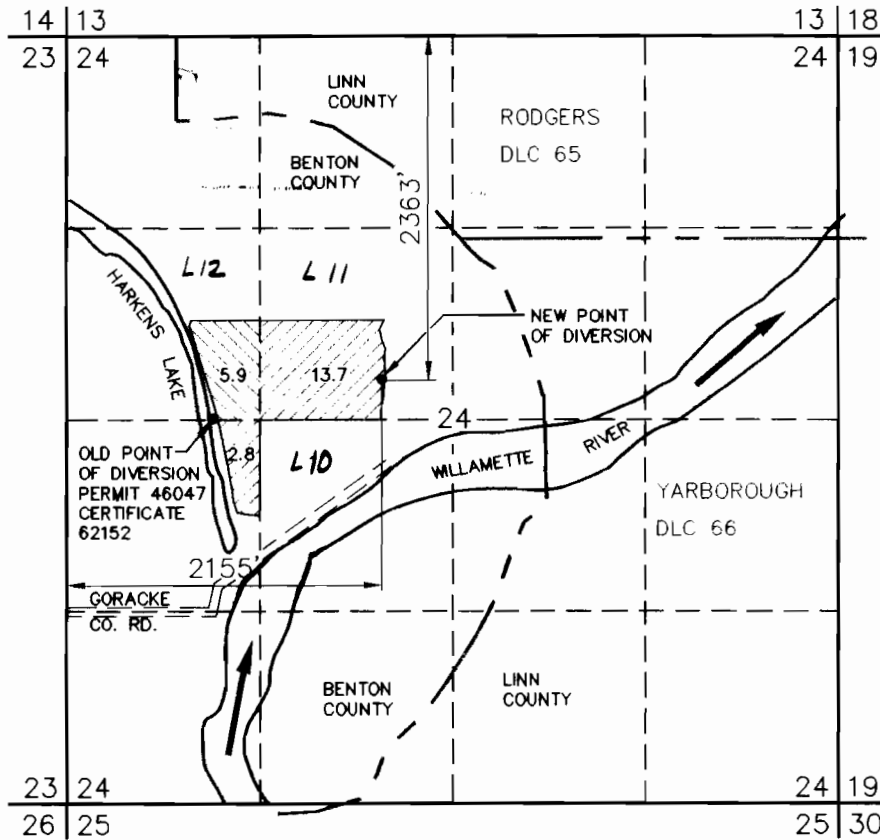

THE OLD POINT OF DIVERSION IS FROM PERMIT NO. 46047. THE PRESENT USE AND ACREAGE BEING IRRIGATED IS THE SAME AS IN PERMIT NO. 46047. THE ORIGINAL SOURCE FOR PERMIT NO. 46047 WAS FROM HARKENS LAKE AS SHOWN. THE NEW SOURCE IS A SHALLOW WELL 35 FEET DEEP AS SHOWN.

I J. EDWARD HENRICKS, BEING DULY SWORN AS A WATER RIGHT EXAMINER LICENSE NO. 170, HAVE PREPARED THIS MAP FOR HORNING ENTERPRISES INC. ON THIS 28 TH DAY OF FEBRUARY 1998. THE AREAS HATCHED REPRESENT THE ACREAGES BEING IRRIGATED.

PREPARATION OF THIS MAP IS FOR THE PURPOSE OF IDENTIFYING THE LOCATION OF THE WATER RIGHT ONLY AND HAS NO INTENT TO PROVIDE DIMENSIONS OR LOCATION OF PROPERTY OWNERSHIP LINES.

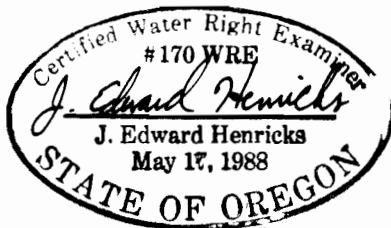

ONLY DOCUMENTS STAMPED WITH RED INK ARE ORIGINALS.

Government lot numbers added to map by OWRD. DC G-14-2009