


T. 5S. R. 1W. WM.

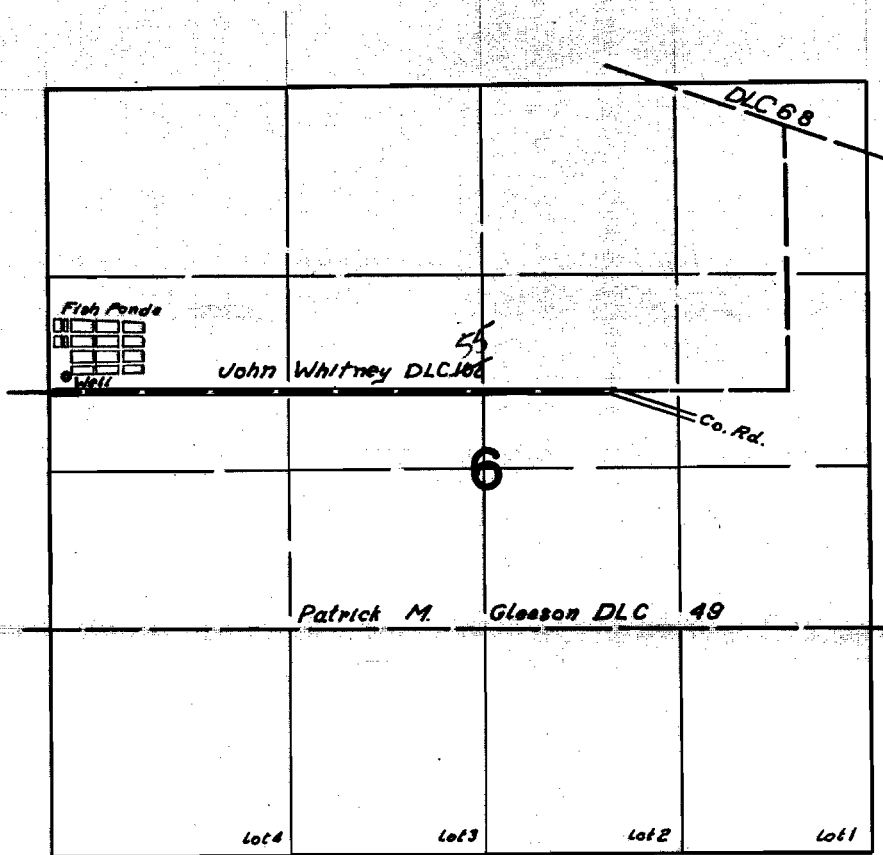

FINAL PROOF SURVEY
UNDER

Application No. *G-1254* Permit No. *G-1012*
IN NAME OF

Albert J. Fajen

Surveyed *April 22 1959*, by *R. H. Jackson*