


800   
5 AC.

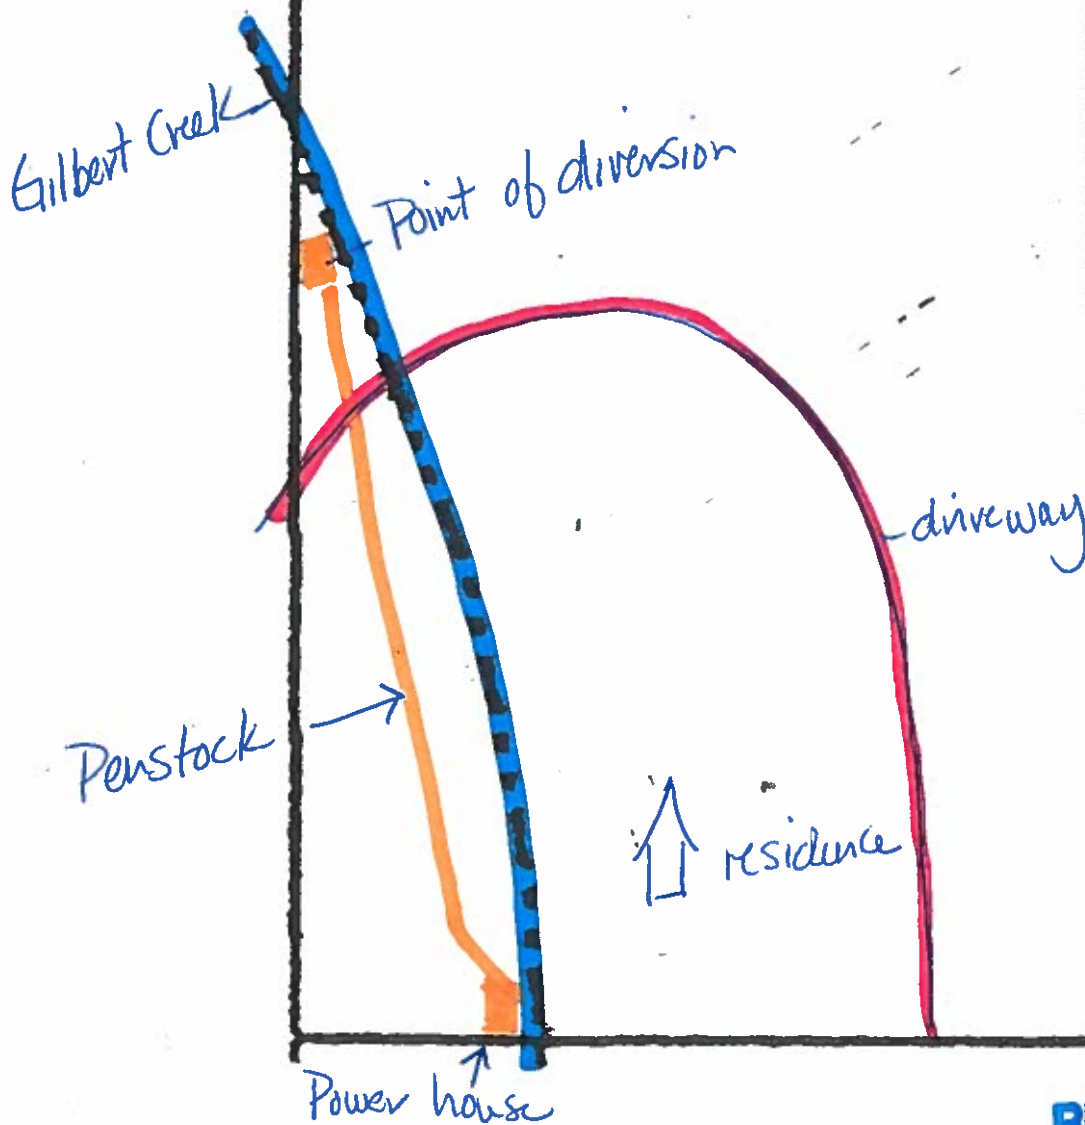


**RECEIVED**

NOV 08 2007

WATER RESOURCES DEPT  
SALEM, OREGON

30.3

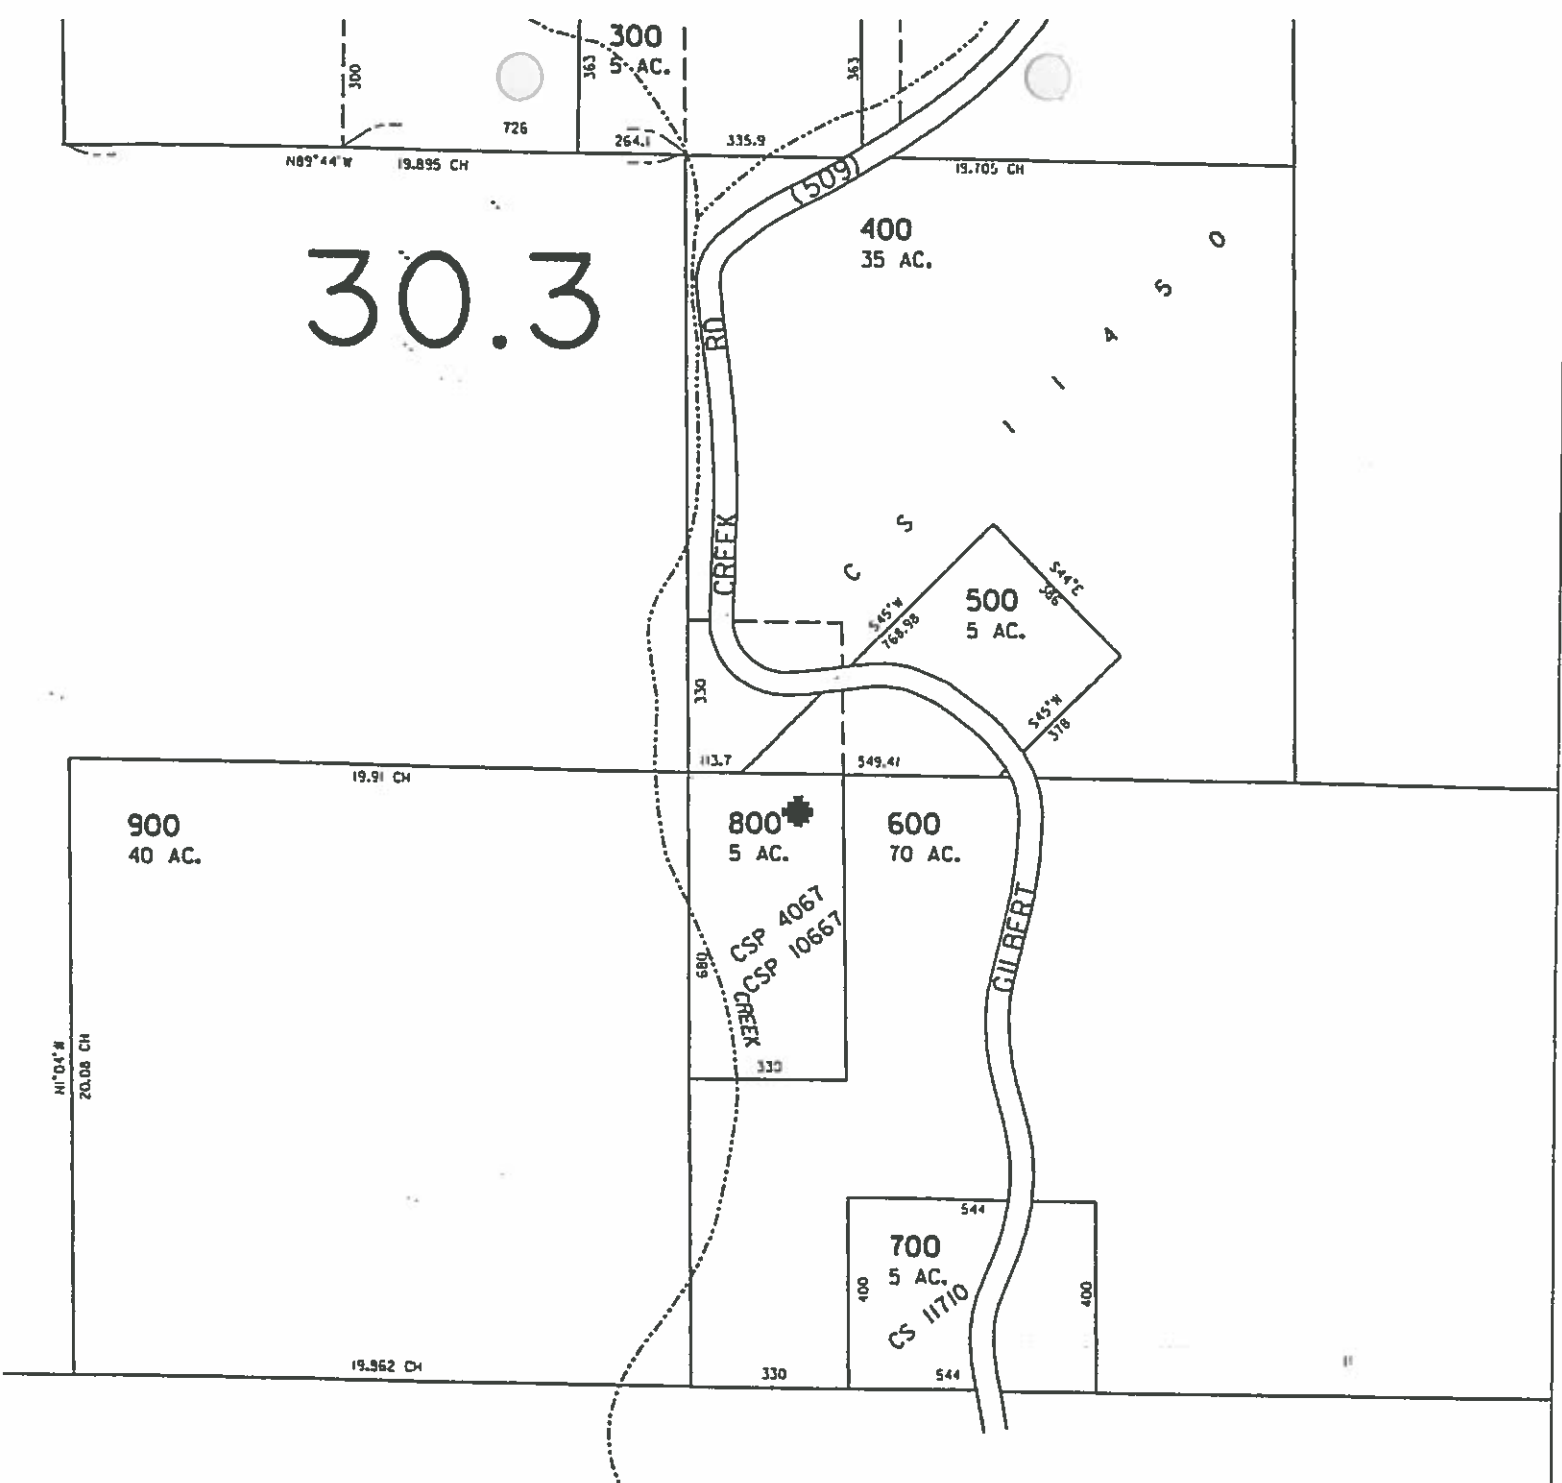

SEE MAP 4 7 34

Exhibit C

This map is made solely for the purpose of assisting in locating said premises and the company assumes no liability for variations, if any, in dimensions and location ascertained by actual survey.

TICOR TITLE INSURANCE COMPANY

**RECEIVED**

NOV 08 2007

**WATER RESOURCES DEPT  
SALEM, OREGON**