


T 4 S, R 2 W, WM

MARION COUNTY

RECEIVED

JAN 16 1996

WATER RESOURCES DEPT.
SALEM, OREGON

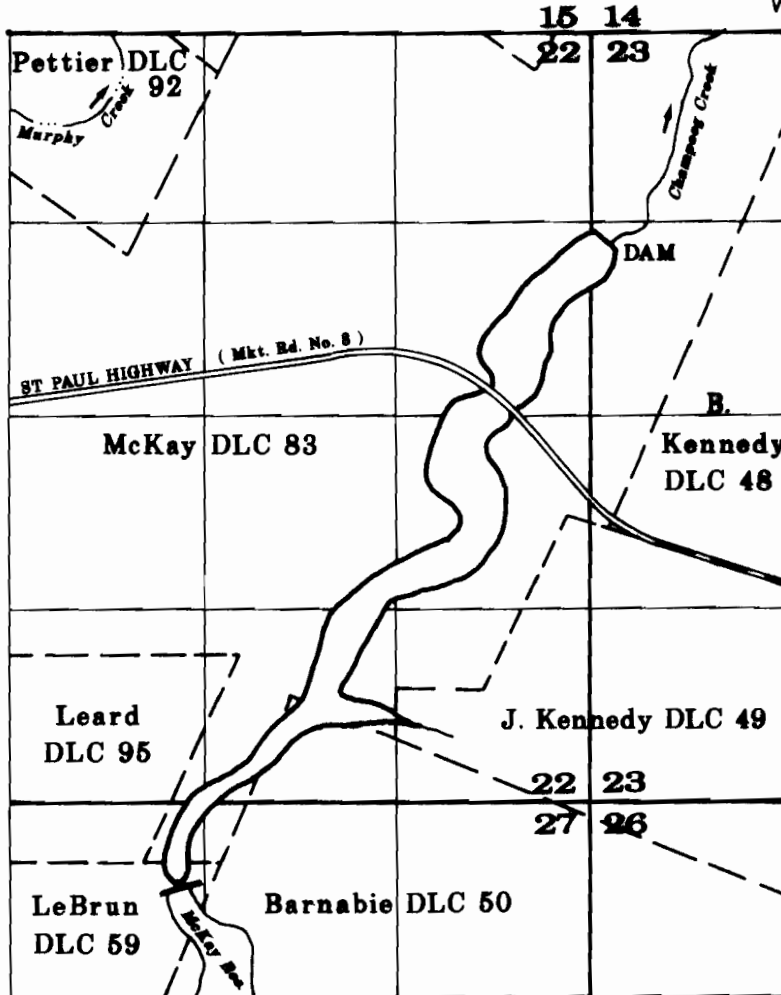

Dam Location: 3000' North & 820' East of the Westerly Interior Angle Corner of the Kennedy DLC No. 49

FINAL PROOF SURVEY

UNDER

Application No. R-44070, Permit No. R-4964, Transfer No. T-6647

IN THE NAME OF

A & R SPADA FARMS

Surveyed January 3, 1996

SCALE: 1" = 1320'



NOTE: This map is for the purpose of identifying the location of water rights and has no intent to dimension or locate property ownership lines.