


T 4 S, R 2 W, WM

MARION COUNTY

RECEIVED

JAN 16 1996

WATER RESOURCES DEPT
SALEM, OREGON

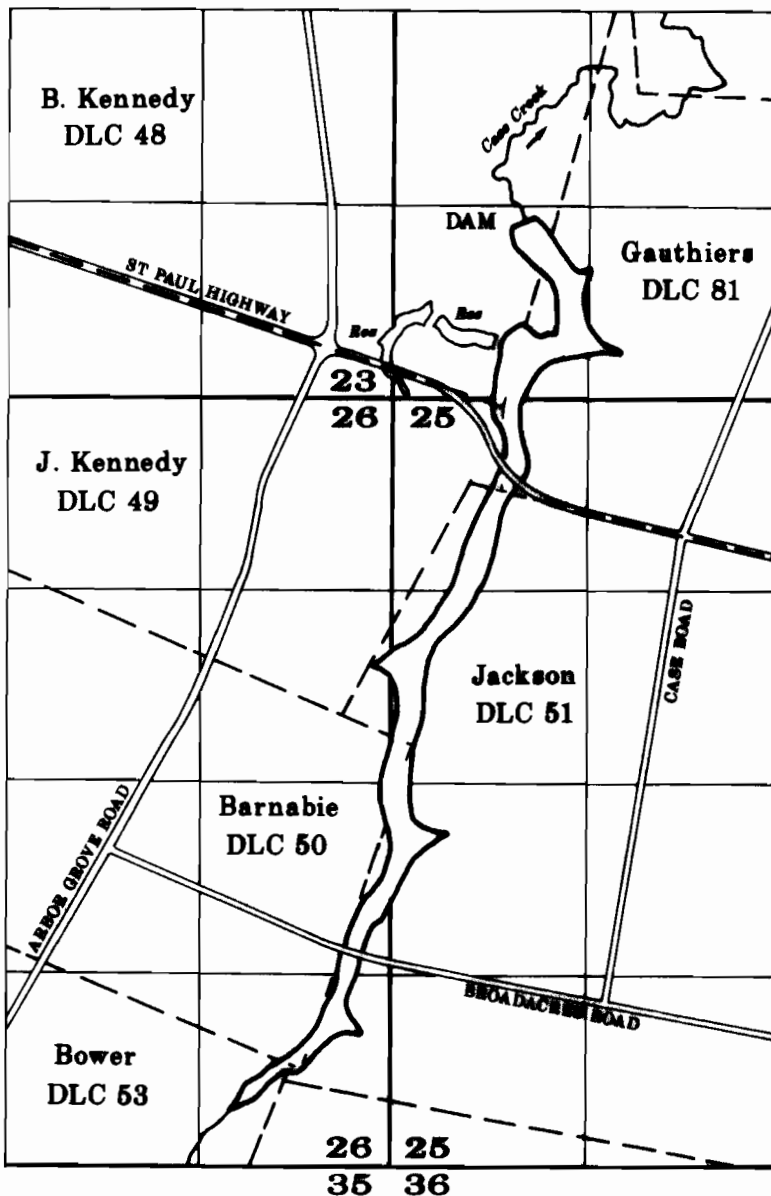

Dam Location: 1790' North & 330' East of the Northwest Corner of the Jackson DLC No. 51

FINAL PROOF SURVEY

UNDER

Application No. R-44864, Permit No. R-5480, Transfer No. T-8648

IN THE NAME OF

A & R SPADA FARMS

Surveyed January 3, 1996

SCALE: 1" = 1320'



NOTE: This map is for the purpose of identifying the location of water rights and has no intention to dimension or locate property or ownership lines.