

CLAIM OF BENEFICIAL USE MAP

Application Nos. G-10846, G-14081, 64552 & 54701 -- Permit Nos. G-10005, G-12850, 47290 & 41864
 Section 13, T9S, R39E, WM -- Western Heights Subdivision -- Baker County, Oregon
 Powder River Basin


Tax Lot Nos. 9-39-13A, 1800 thru 3800; 9-39-13B, 200 thru 2200; 9-39-13C, 200; and 9-39-13D, 100 Thru 600

Revised 6/10/2007

RECEIVED

JUN 18 2007

WATER RESOURCES DEPT
 SALEM, OREGON

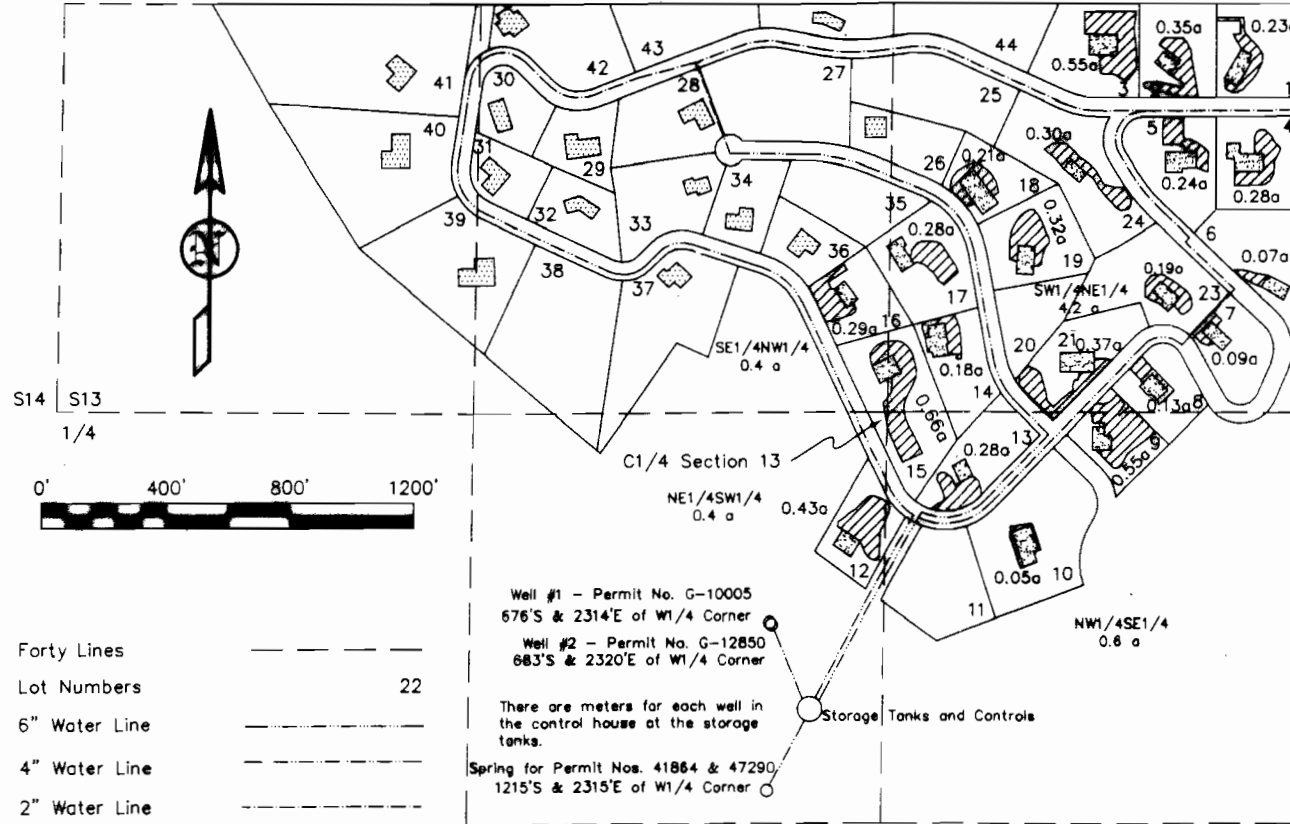

- Permit No. 41864 with Permit No. G-10005 and Supplement Permit No. G-12850
 - Dwelling
 - & Irrigation
- Permit No. 47290 with Permit No. G-10005 and Supplement Permit No. G-12850
 - Dwelling with Irrigation

This map is for the purpose of identifying the location of the water right only and has no intent to provide dimensions or location of property ownership lines.

