

CLAIM OF BENEFICIAL USE MAP


Application Nos. G-10846, G-14081, 64552 & 54701 -- Permit Nos. G-10005, G-12850, 47290 & 41864
 Section 13, T9S, R39E, WM -- Western Heights Subdivision -- Baker County, Oregon
 Powder River Basin

Tax Lot Nos. 9-39-13A, 1800 thru 3800; 9-39-13B, 200 thru 2200; 9-39-13C, 200; and 9-39-13D, 100 Thru 600
 Revised 6/10/2007

RECEIVED


JUN 18 2007

WATER RESOURCES DEPT
 SALEM OREGON

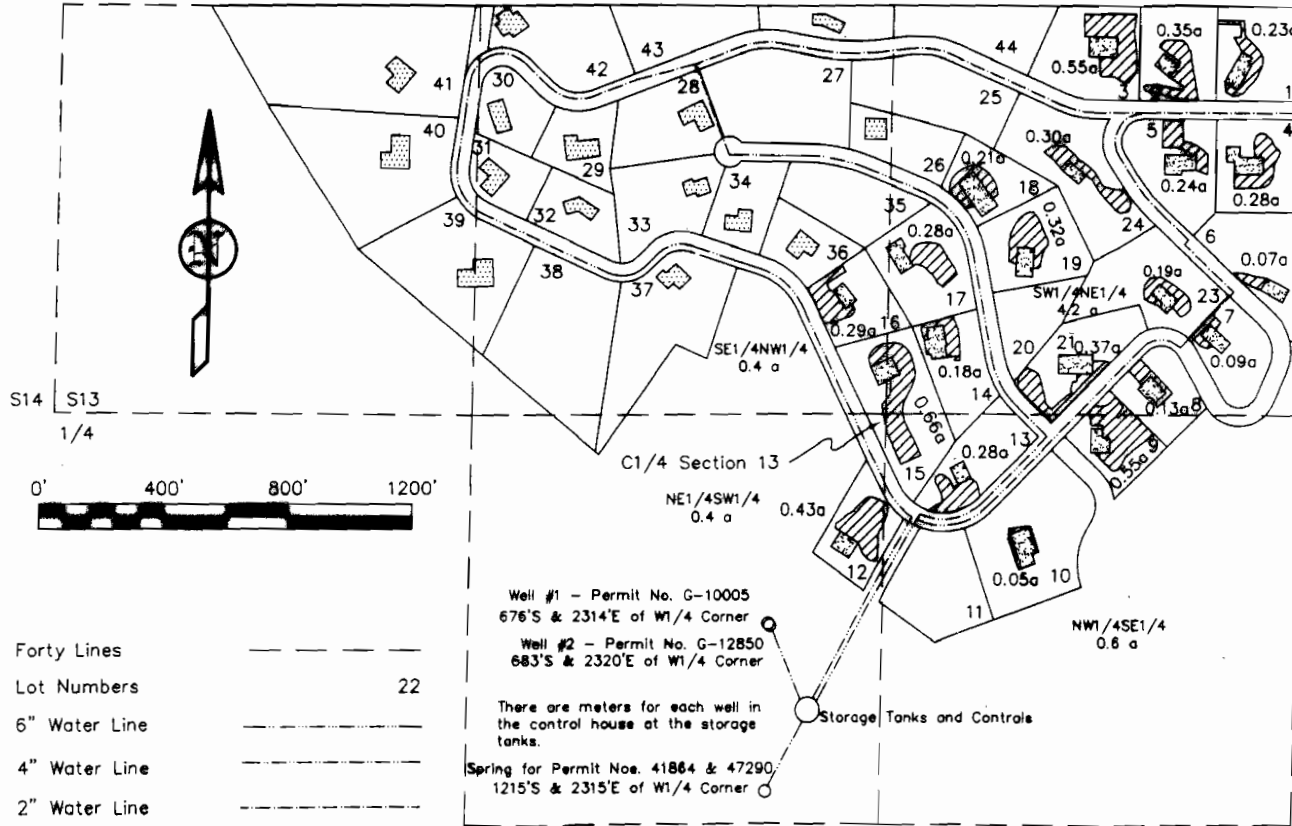

- Permit No. 41864 with
 Permit No. G-10005 and
 Supplement Permit No. G-12850
 - Dwelling
 - & Irrigation
- Permit No. 47290 with
 Permit No. G-10005 and
 Supplement Permit No. G-12850
 - Dwelling with Irrigation

This map is for the purpose of identifying the location of the water right only and has no intent to provide dimensions or location of property ownership lines.

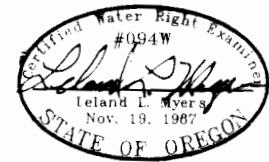

- Forty Lines -----
- Lot Numbers ----- 22
- 6" Water Line -----
- 4" Water Line -----
- 2" Water Line -----