

# CLAIM OF BENEFICIAL USE MAP


Application Nos. G-10846, G-14081, 64552 & 54701 -- Permit Nos. G-10005, G-12850, 47290 & 41864  
 Section 13, T9S, R39E, WM -- Western Heights Subdivision -- Baker County, Oregon  
 Powder River Basin

Tax Lot Nos. 9-39-13A, 1800 thru 3800; 9-39-13B, 200 thru 2200; 9-39-13C, 200; and 9-39-13D, 100 Thru 600  
 Revised 6/10/2007

**RECEIVED**

JUN 18 2007

WATER RESOURCES DEPT  
 SALEM, OREGON

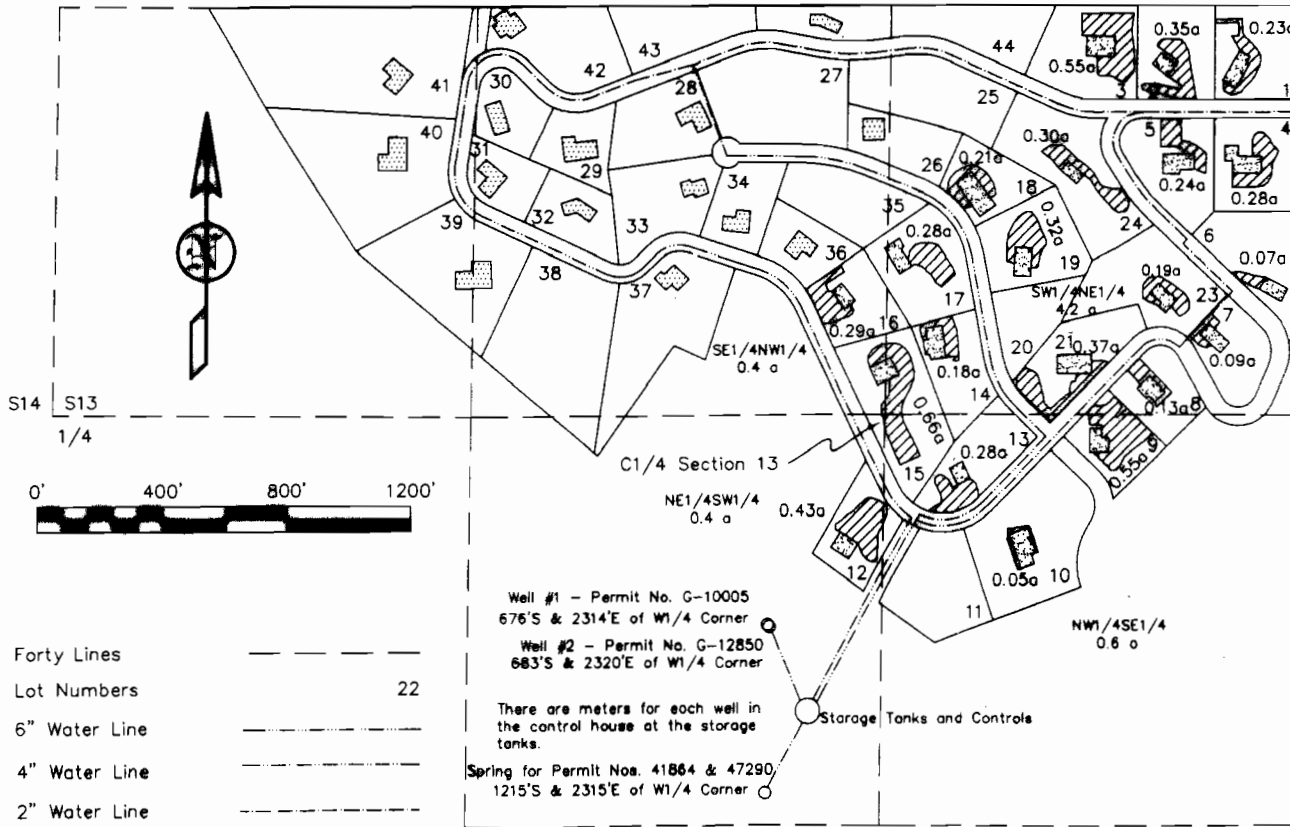

- Permit No. 41864 with  
 Permit No. G-10005 and  
 Supplement Permit No. G-12850
- Dwelling
- & Irrigation
- Permit No. 47290 with  
 Permit No. G-10005 and  
 Supplement Permit No. G-12850
- Dwelling with Irrigation

This map is for the purpose of identifying the location of the water right only and has no intent to provide dimensions or location of property ownership lines.

- Forty Lines -----
- Lot Numbers 22 -----
- 6" Water Line -----
- 4" Water Line -----
- 2" Water Line -----

Well #1 - Permit No. G-10005  
 676'S & 2314'E of W1/4 Corner  
 Well #2 - Permit No. G-12850  
 683'S & 2320'E of W1/4 Corner  
 There are meters for each well in  
 the control house at the storage  
 tanks.  
 Spring for Permit Nos. 41864 & 47290  
 1215'S & 2315'E of W1/4 Corner

