

Location: SE1/4 SE1/4, Section 21,  
T. 4 S., R. 4 W., WM, Yamhill Co., OR

Tax Lot: 4421DD 1400,1900


Scale : 1" = 400'

Deed recorded in Film Volume 251 Page 2050



LEGEND:

- - - - - = section subdivision line
- . . — = property line

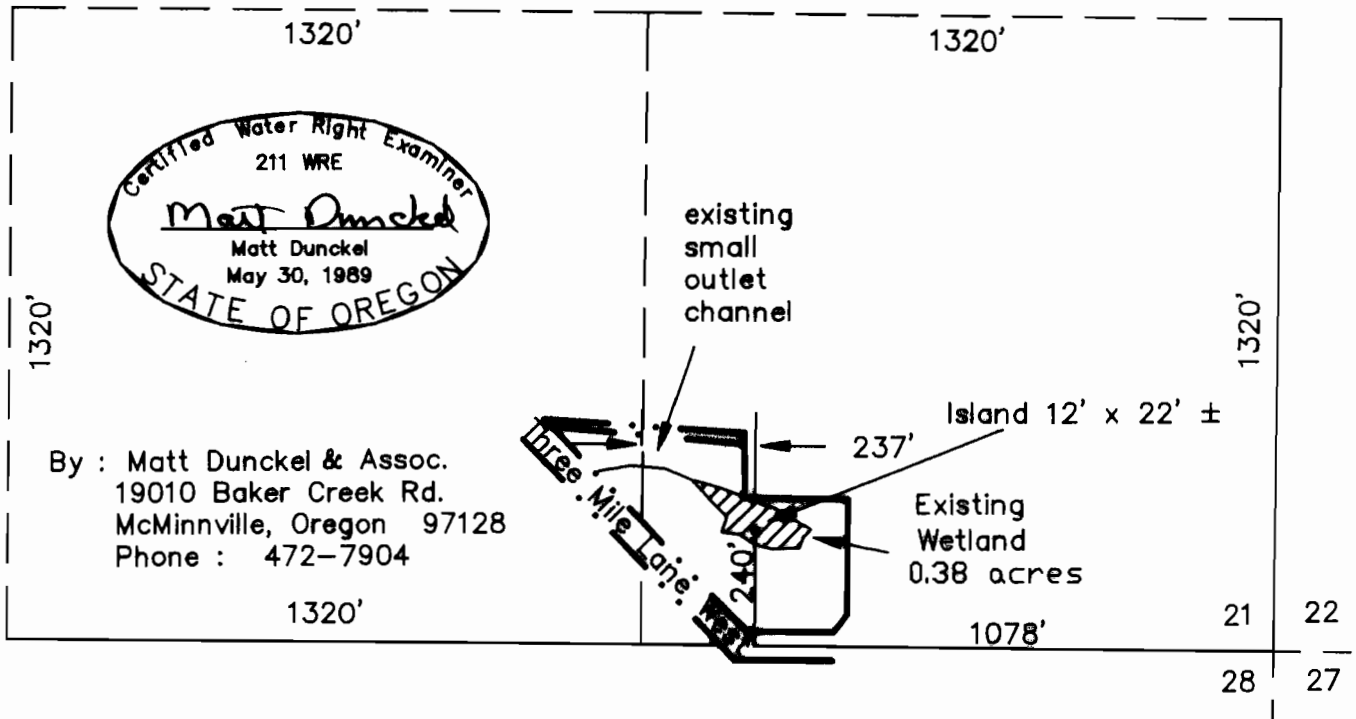

By : Matt Dunkel & Assoc.  
19010 Baker Creek Rd.  
McMinnville, Oregon 97128  
Phone : 472-7904

**FINAL PROOF SURVEY**  
UNDER

Application No. R-72246 Permit No. R-11467

IN NAME OF

**John Hitchcock**

Surveyed Dec. 12 1992