


T. 34 S., R. 5 W., W. M.

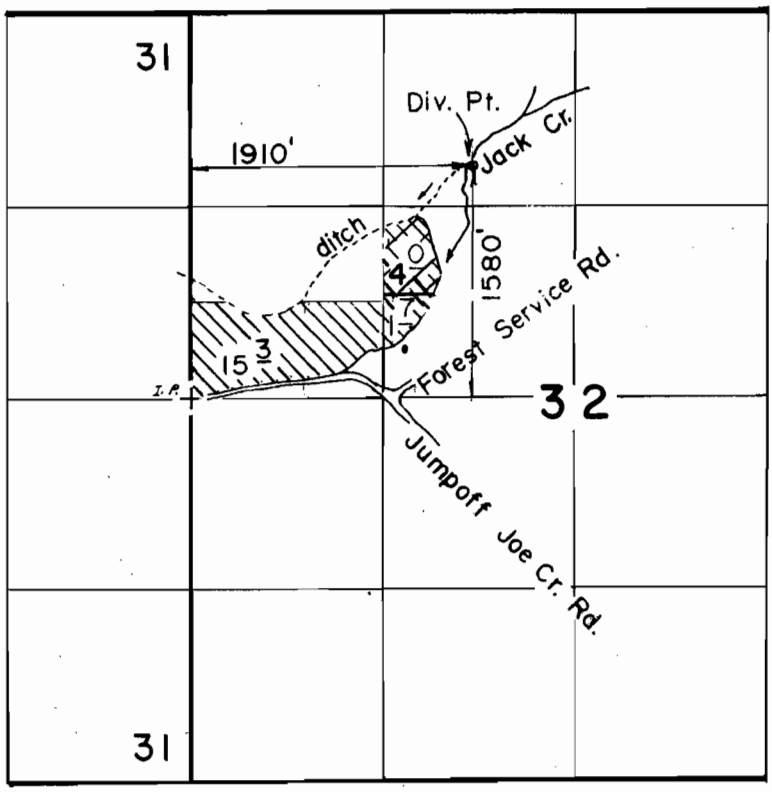

Scale: 1" = 1320'

### FINAL PROOF SURVEY UNDER

Application No. **65052** Permit No. **47.792**  
IN NAME OF

..PORTOLA LUMBER CO. AND.....MARTIN.....

Surveyed O.C.T...29. 19.8.7, by B...S.....JAMES..