




T. 34 S., R. 5 W., W. M.

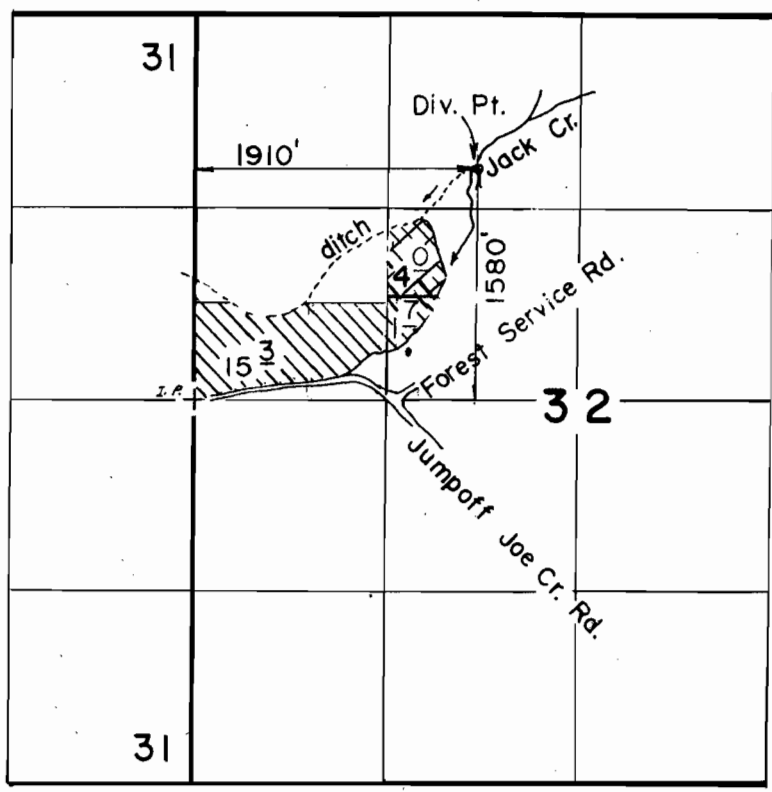

Scale: 1" = 1320'

FINAL PROOF SURVEY UNDER

Application No. 65052 Permit No. 47792
IN NAME OF

 PORTOLA LUMBER CO. AND  MARTIN

Surveyed O.C.T. 29 1987, by B. S. JAMES.