


FINAL PROOF MAP DEPICTING CHANGE IN POINT OF DIVERSION FOR TRANSFER T-7741

TOWNSHIP 26 SOUTH
RANGE 15 EAST, W.M.
LAKE COUNTY, OREGON


NOTE: PREPARATION OF THIS MAP IS FOR IDENTIFYING PROPOSED
WATER RIGHTS ONLY. IT HAS NO INTENT TO PROVIDE LOCATIONS
OR DIMENSIONS OF PROPERTY BOUNDARIES.

SCALE 1"=1320'

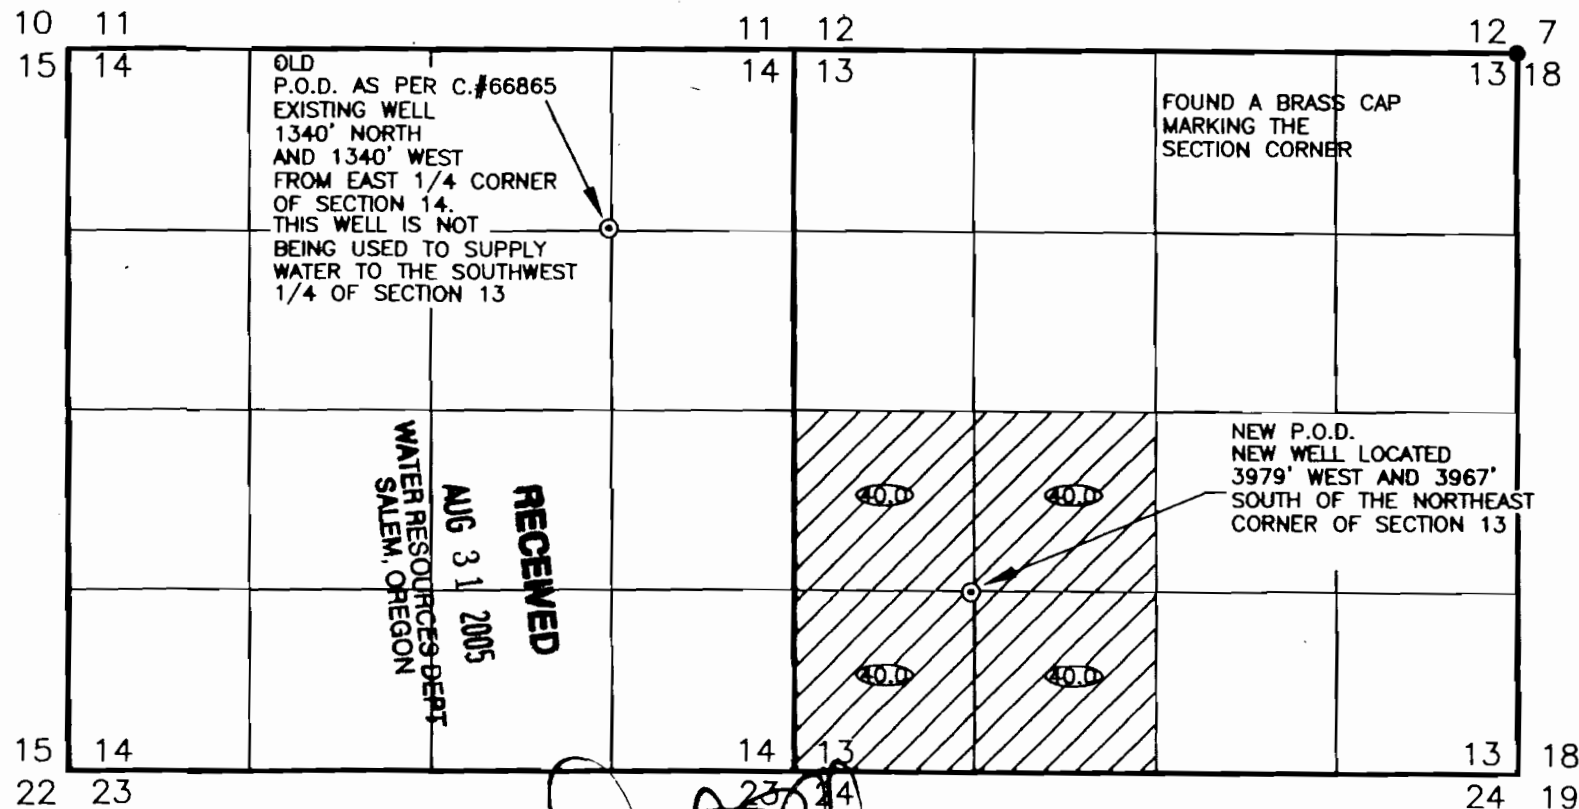

LEGEND

- SECTION LINES
- 1/4 SECTION LINES
- 1/16 SECTION LINES
- FOUND LAND SURVEY MONUMENT

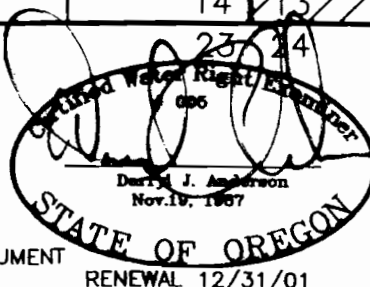

160.0 ACRES UNDER CERTIFICATE
#66865.

SEE ACCOMPANYING
SITE REPORT

ANDERSON ENGINEERING
AND SURVEYING, INC.

P.O. BOX 419
LAKEVIEW, OREGON 97638
(503) 947-1487
FAX 503-438-1008

PREPARED FOR: SAM DINSDALE
HC 61 BOX 9606
SILVER LAKE, OR 97638

DATE: 5/15/00
SCALE: 1"=1320'
BY: [Signature]
CHKD BY: [Signature]
FAC: [Signature]
SHEET 1 OF 1