
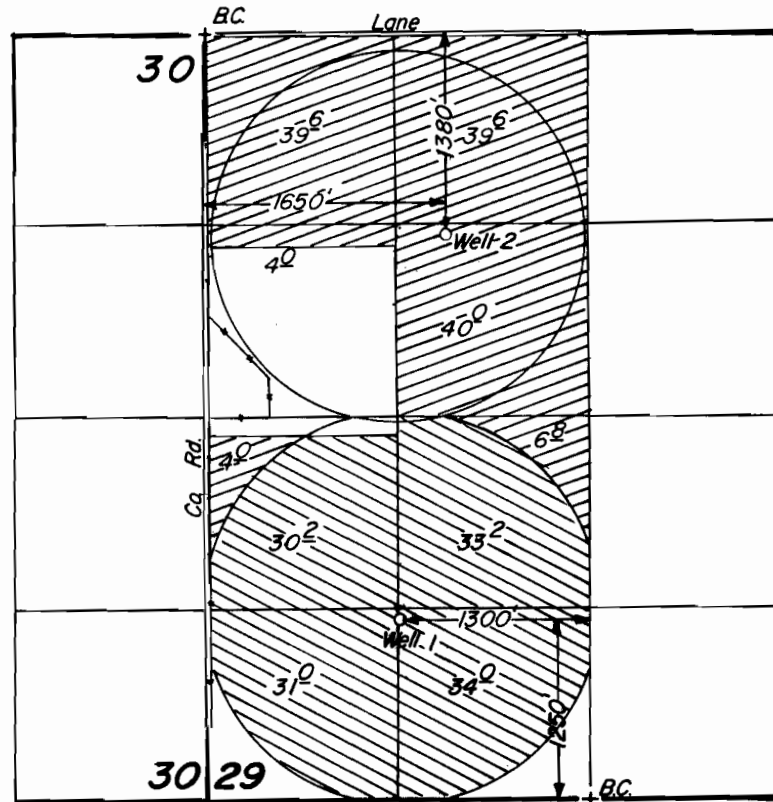


T.26 S., R.15 E., W.M.

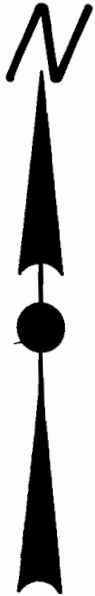

Well 1 
Well 2 

Scale: 1" = 1320'

FINAL PROOF SURVEY UNDER

Application No. G-6870 Permit No. G-6406....

IN NAME OF

JAMES DINSDALE

Surveyed Oct. 12.... 1985., by T. Warren.....