


FINAL PROOF SURVEY

T.15S., R.12E., SECTION 3
DESCHUTES COUNTY, OREGON

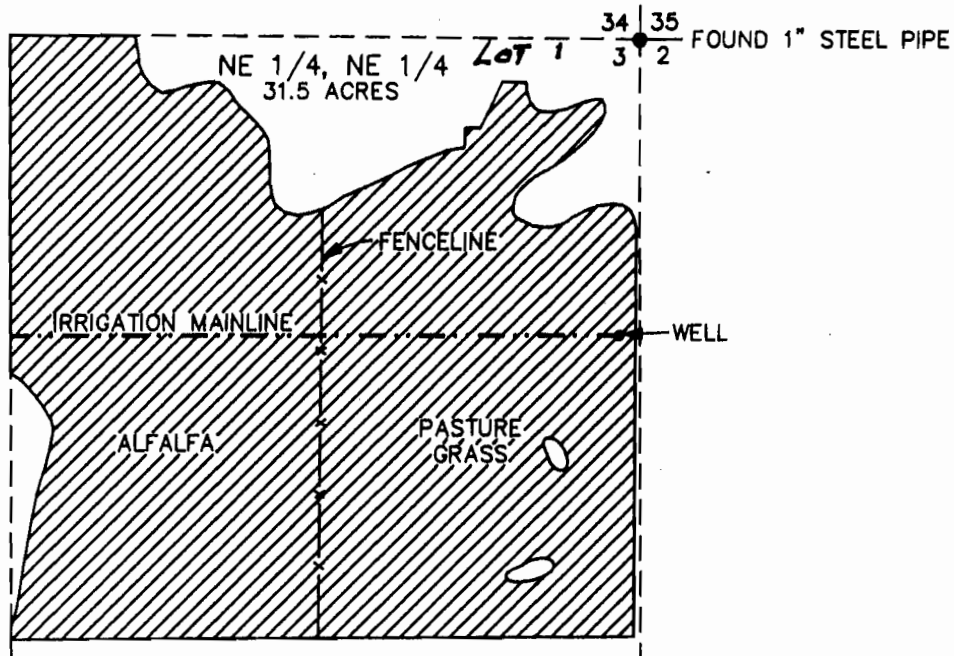

SCALE: 1" = 400'
DATE: MAY 9, 1991

THE WELL IS LOCATED 614 FEET SOUTH AND
45 FEET WEST FROM THE NE CORNER OF
SECTION 3, T.15S., R.12E., W.M.,
DESCHUTES COUNTY, OREGON

THIS MAP IS FOR THE PURPOSE
OF LOCATING A WATER RIGHT
AND IS NOT INTENDED TO
PROVIDE LEGAL DIMENSIONS FOR
PROPERTY BOUNDARIES.



AMENDED 12/18/07 LHM

scale	1" = 400'	design
date	1/21/93	drawn JHL
file	WREX0011 - WREX0011.DWG (713)	



DAVID EVANS AND ASSOCIATES, INC
709 NW WALL STREET, SUITE 102
BEND, OREGON 97701 (503)389-7614

WATER RIGHTS MAP
FOR

GARY D. ROSSI &
NANCY A. BORNEMAN