


RECEIVED


JUL 16 1996

WATER RESOURCES DEPT.  
SALEM, OREGON

74  
Ac.

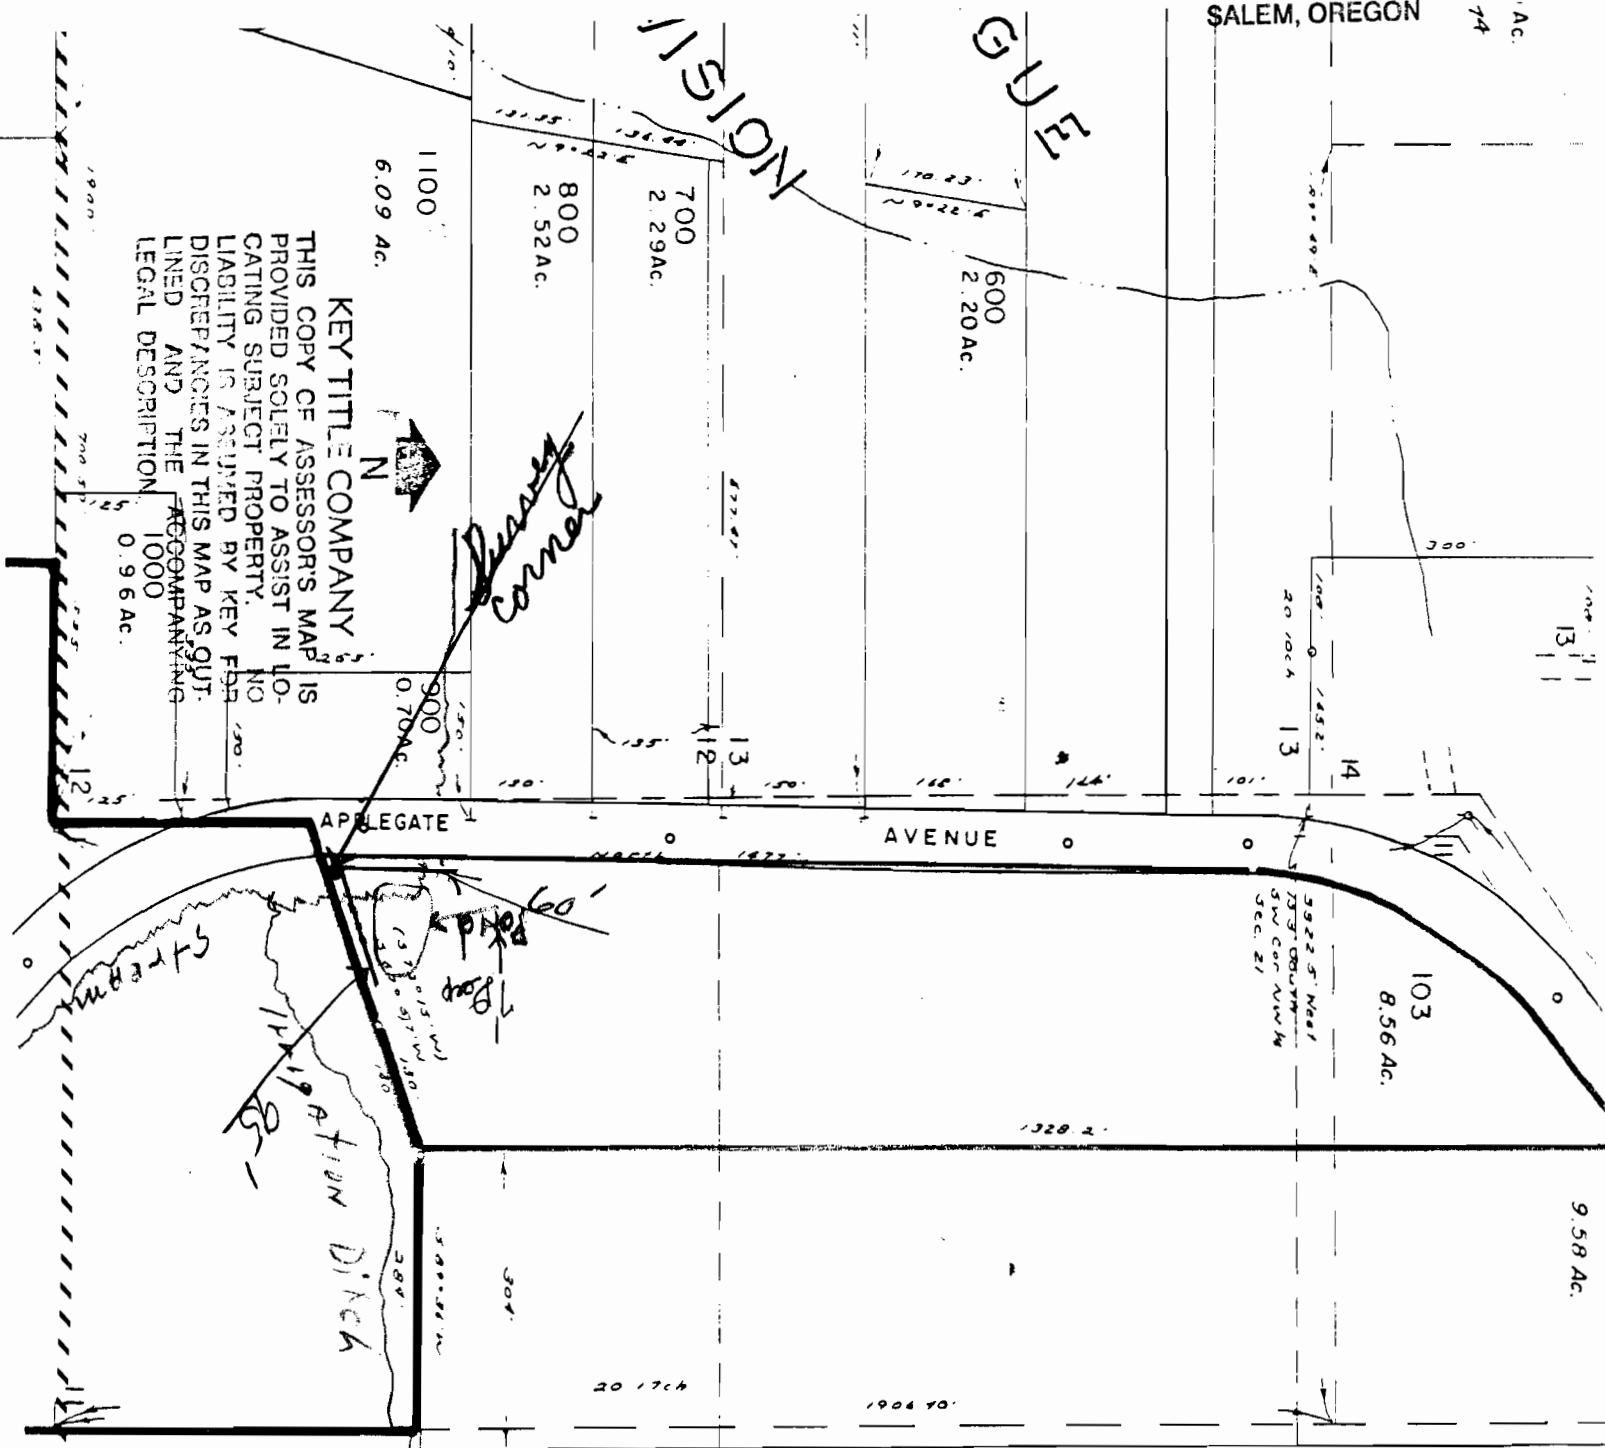

KEY TITLE COMPANY  
THIS COPY OF ASSESSOR'S MAP IS  
PROVIDED SOLELY TO ASSIST IN I.D.  
CATING SUBJECT PROPERTY. NO  
LIABILITY IS ASSUMED BY KEY TITLE  
DISCREPANCIES IN THIS MAP AS QUT.  
LINED AND THE ACCOMPANYING  
LEGAL DESCRIPTION  
1000  
0.96 Ac.

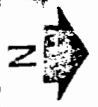

*Corner*

*1985*  
*STORM DRAIN*  
*1985*

206  
101  
102

*SW 1/4 Sec. 20*

*T 36 S, R. 6 W*

*W. M.*

*Josephine county*

*Map 36 to 203  
& INDEX*