


RECEIVED

JAN 16 2003

WATER RESOURCES DEPT.
SALEM, OREGON

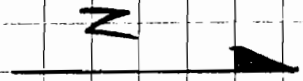


1" = 660'

Wildcat Rd.

Application Map

For Matt Beyer, 12506 S. Wildcat Rd.

Section 6 T.6.S. R.2.E. W.M.

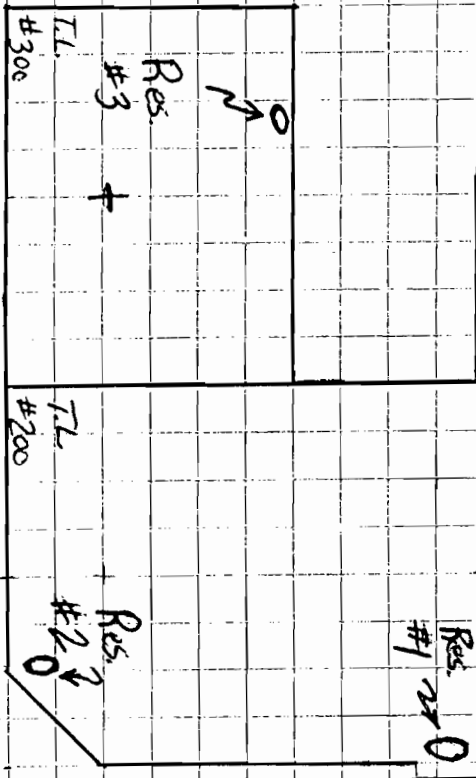

Res. #1 located 1350' S & 660' W From NE corner Section 6
Res. #2 located 2805' S & 990' W From NE corner Section 6
Res. #3 located 1980' S & 2900' W From NE corner Section 6

RECEIVED

OCT 11 2007

WATER RESOURCES DEPT.
SALEM, OREGON

31 32
6 5

(#1)

app# R-95423 Permit # R-13644