


RECEIVED
 JAN 16 2003
 WATER RESOURCES DEPT.
 SALEM, OREGON

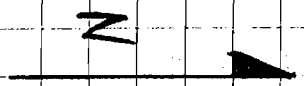


1" = 660'

Application Map

For Matt Beyer, 12506 S. Wilcat Rd.

Section 6 T.6.S. R.2.E. W.M.

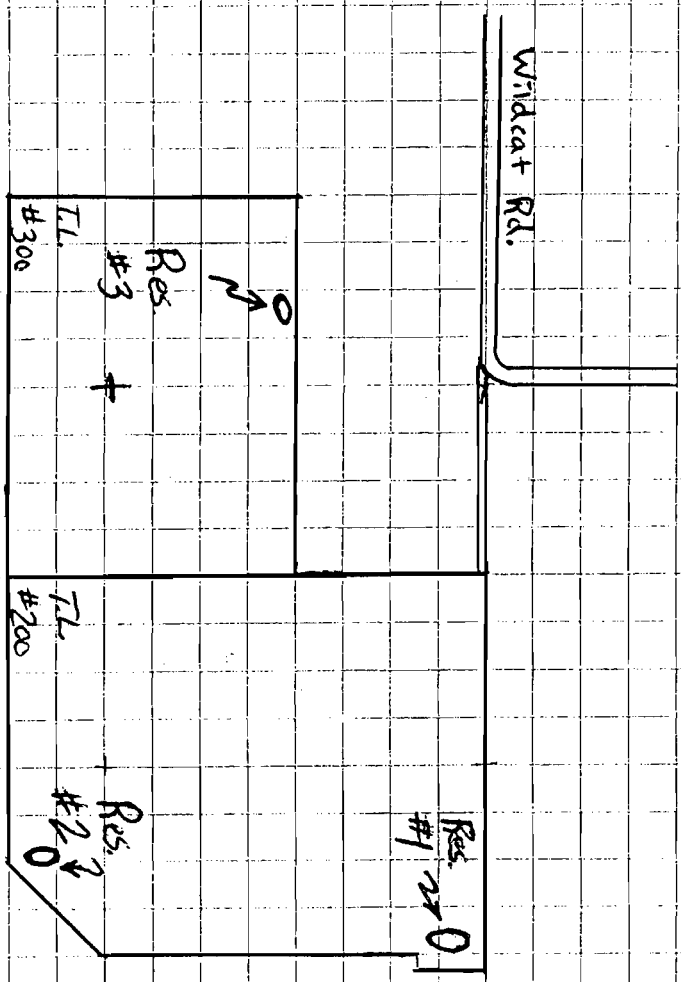

Res. #1 located 1350' S & 660' W From NE corner Section 6
 Res. #2 located 2805' S & 990' W From NE corner Section 6
 Res. #3 located 1980' S & 2900' W From NE corner Section 6

RECEIVED

OCT 31 2007

WATER RESOURCES DEPT.
 SALEM, OREGON

31 32
 6 5

#2

app# R-95424 Permit #

Permit # R-13645

Rock

Creek

1/4 corner