


T. 26S., R. 4W., W.M.

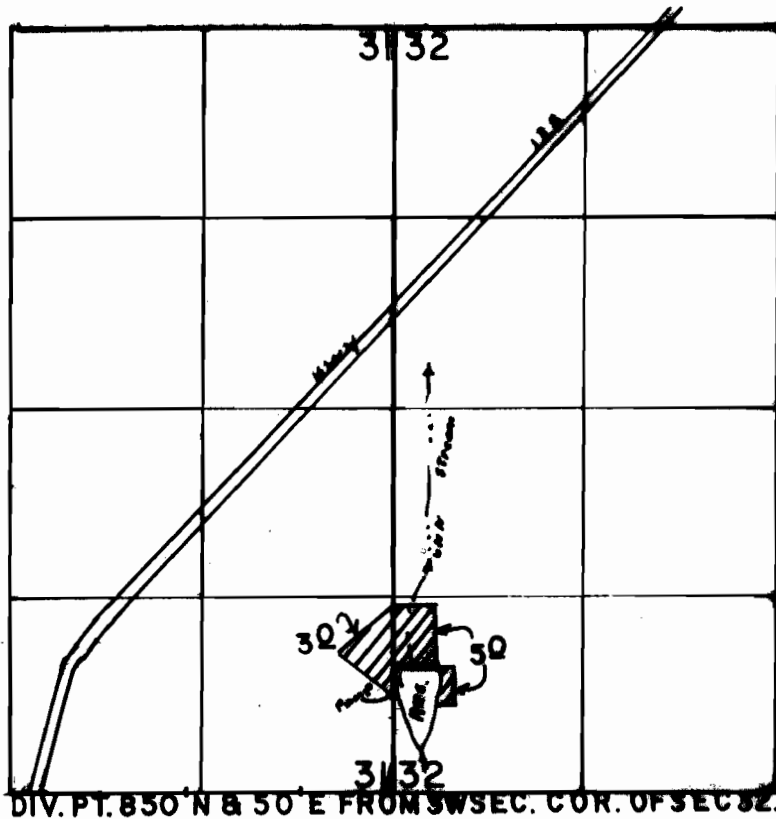

SCALE: 1" = 1320'

**FINAL PROOF SURVEY  
UNDER**

64543                      47456

Application No. R-59217    Permit No. R-9665...  
IN NAME OF

PETER B. SERAFIN

Surveyed JUNE 3, 1997, by R.M. SUTTERFIELD.