
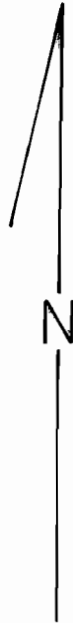


T. 26 S., R. 4 W., W.M.

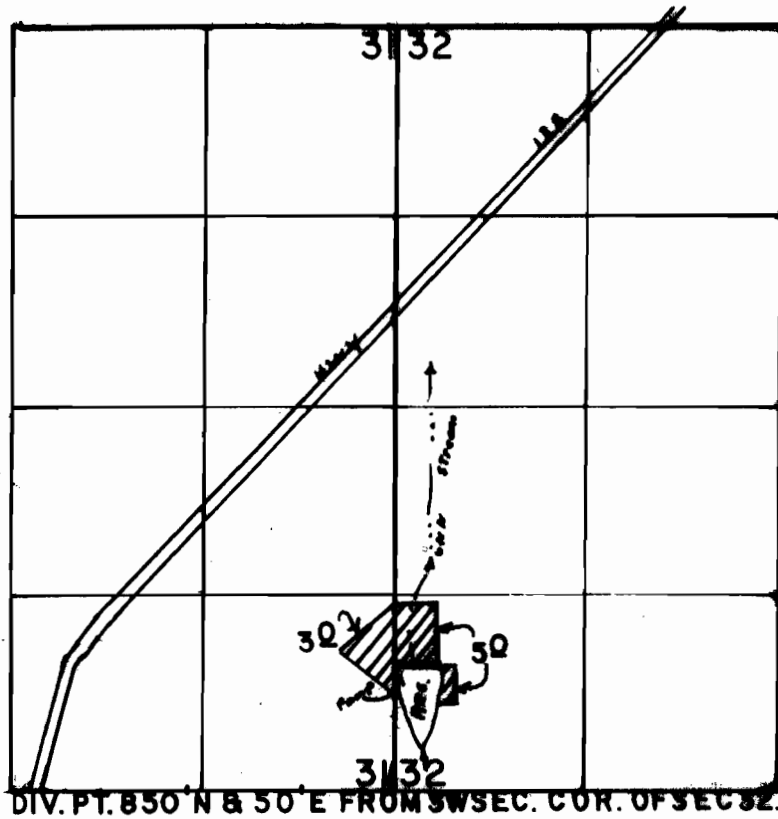

SCALE: 1" = 1320'

**FINAL PROOF SURVEY**  
**UNDER**

64543                      47456  
Application No. R-58217    Permit No. R-8865...  
IN NAME OF

PETER B. SERAFIN

Surveyed JUNE 3, 1997, by R.M. SUTTERFIELD