

Map of Beneficial Use  
Under  
APPLICATION s-73399

in the name of  
**TRAVIS HILL**  
7091 Springhill Drive  
Albany, OR 97321

Date of Survey - December 18, 1997  
Date of Map - December 18, 1997

Tax Lot: 500, 600, 801, 1000 (10-4W-15)  
100, 101 (10-4-14)  
Source: Willamette Basin Project  
(Contract 5-07-10-1053)


Area of Irrigation

Under S-73399, there are 164.2 acres being put to beneficial use as specified by quarter-quarter sections on the herein attached map. This irrigation area is a combination of primary and supplemental rights as specified.

AREA	PRIM.	SUPP.	TOTAL
SW, NW of 14	0.7	11.2	11.9 Ac.
SE, NW of 14	1.2	3.6	4.8 Ac.
NW, SW of 14	8.2	11.2	19.4 Ac.
NE, SW of 14	0.4	1.0	1.4 Ac.
SW, NE of 15	15.5	16.7	32.2 Ac.
SE, NE of 15	25.5	0.7	26.2 Ac.
NW, SE of 15	9.7	15.3	25.0 Ac.
NE, SE of 15	27.4	2.1	29.5 Ac.
SW, SE of 15	0.3	0.5	0.8 Ac.
SE, SE of 15	1.7	11.3	13.0 Ac.
<b>TOTAL</b>	<b>90.6</b>	<b>73.6</b>	<b>164.2 Ac.</b>

NOTE:

THIS APPLICATION SHALL NOT WAIVE GR-2696, GR-2697, OR GR-2698 WHICH ARE PENDING WATER RIGHTS WAITING FOR LEGAL RECOGNITION.

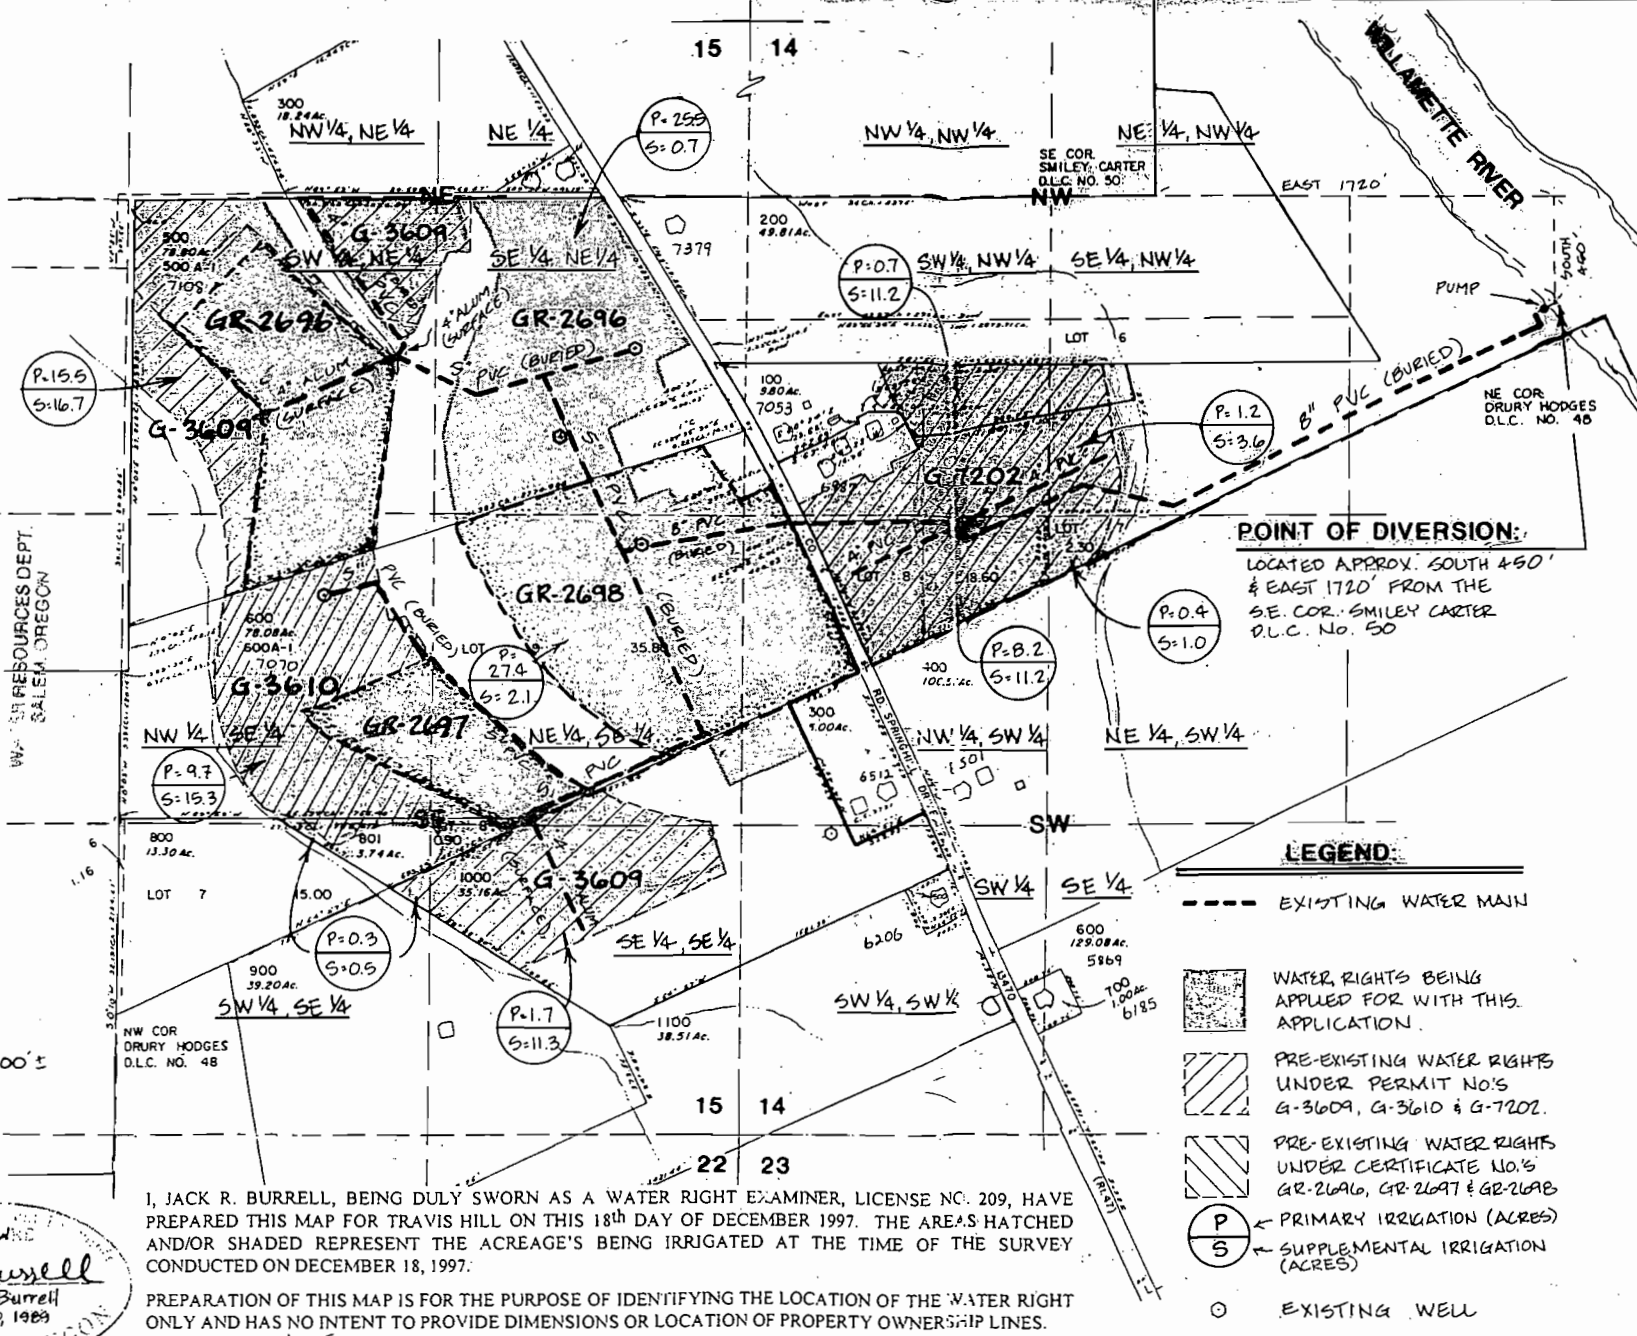

**POINT OF DIVERSION:**

LOCATED APPROX. SOUTH 450'  
& EAST 1720' FROM THE  
SE. COR. SMILEY CARTER  
D.L.C. NO. 50

**LEGEND:**

- EXISTING WATER MAIN
- [Stippled Box] WATER RIGHTS BEING APPLIED FOR WITH THIS APPLICATION.
- [Diagonal Hatched Box] PRE-EXISTING WATER RIGHTS UNDER PERMIT NO.'S G-3609, G-3610 & G-7202.
- [Diagonal Hatched Box] PRE-EXISTING WATER RIGHTS UNDER CERTIFICATE NO.'S GR-2696, GR-2697 & GR-2698
- (P) PRIMARY IRRIGATION (ACRES)
- (S) SUPPLEMENTAL IRRIGATION (ACRES)
- (O) EXISTING WELL

RECEIVED  
DEC 13 1997

WATER RESOURCES DEPT.  
SALEM, OREGON



SCALE: 1" = 600'

I, JACK R. BURRELL, BEING DULY SWORN AS A WATER RIGHT EXAMINER, LICENSE NO. 209, HAVE PREPARED THIS MAP FOR TRAVIS HILL ON THIS 18<sup>TH</sup> DAY OF DECEMBER 1997. THE AREAS HATCHED AND/OR SHADED REPRESENT THE ACREAGE'S BEING IRRIGATED AT THE TIME OF THE SURVEY CONDUCTED ON DECEMBER 18, 1997.

PREPARATION OF THIS MAP IS FOR THE PURPOSE OF IDENTIFYING THE LOCATION OF THE WATER RIGHT ONLY AND HAS NO INTENT TO PROVIDE DIMENSIONS OR LOCATION OF PROPERTY OWNERSHIP LINES.

209 W.R.E.  
*Jack R. Burrell*  
Jack R. Burrell  
May 30, 1989  
STATE OF OREGON

EXPIRATION DATE 12/31/97

**KD ENGINEERING, INC.**  
202 NW HICKORY STREET  
POST OFFICE BOX 725  
ALBANY, OREGON 97321

**HILL WATER RIGHT**

IN SEC.'S 14 & 15, T.10S., R.4W., W.M., BENTON CO., ORE.

DSGN. BY: N/A	SCALE: 1" = 600'	SHEET NO.
DWG. BY: M.M.S.	DATE: DEC. 18, 1997	
CKD. BY: J.R.B.	PROJECT NO: 91-123A	