


T. 37 S., R. 5 W., W.M.

16 15  
21 22

Scale: 8 inches = 1 mile

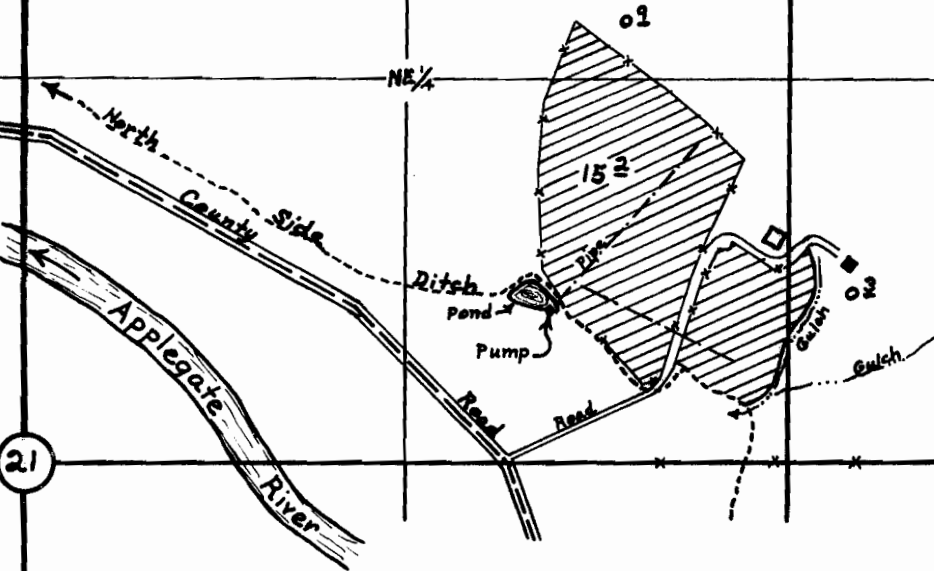

# FINAL PROOF SURVEY

UNDER

Application No. 29769 Permit No. 23443  
IN NAME OF

Oscar J. Larsen

Surveyed March 3 1959, by D.C. Hendrix, W.M.