

T-5276


T.8&9S.R.24&25E.W.M.

RECEIVED

JUN 1 1983

WATER RESOURCES DEPT.  
SALEM, OREGON

4" = 1 mile

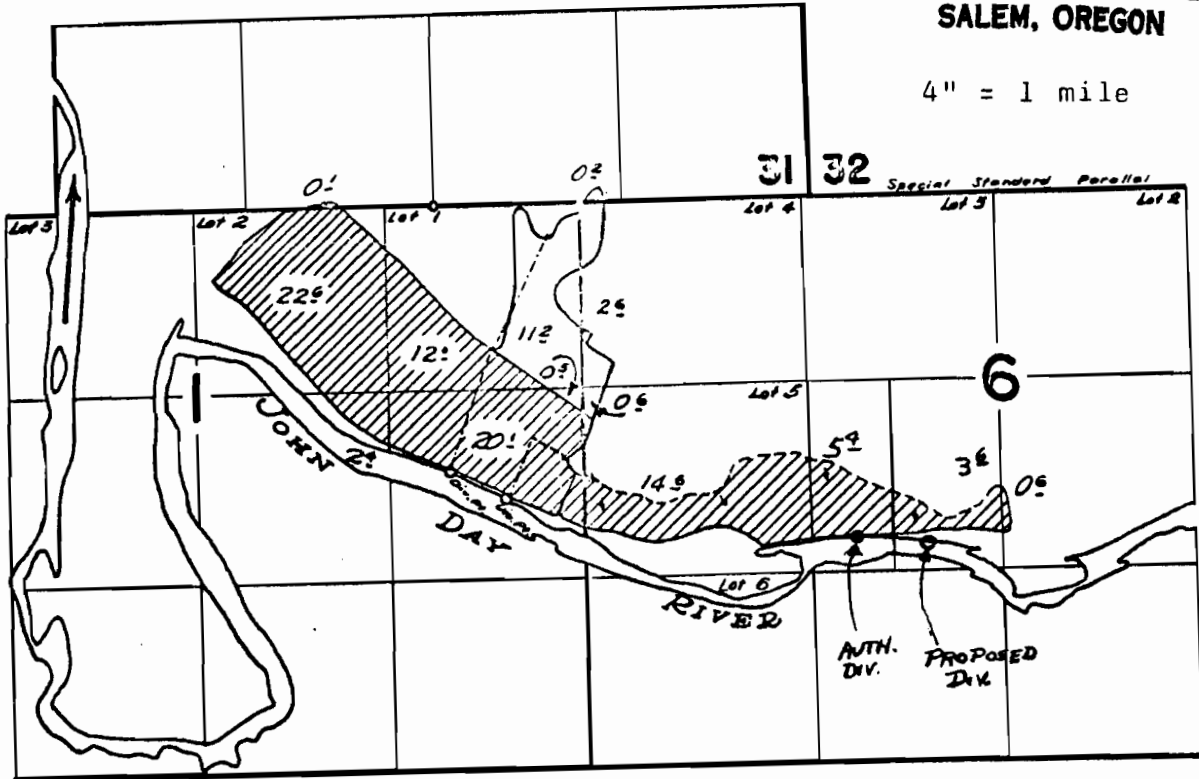

Authorized Div. - 1560'N & 1870'E from SW corner Sec. 6

Proposed Div. - 1500'N & 2350'E from SW corner Sec. 6

That part of the East 755 feet of  
 the N.E.  $\frac{1}{4}$  S.W.  $\frac{1}{4}$  of Section 6, Township 9  
 South, Range 25 East, W.M., Wheeler County,  
 Oregon, lying north of the center of the  
 John Day River.